

MISSISSIPPI
BOARD OF WATER COMMISSIONERS
416 North State Street
Jackson, Mississippi 39201

CODED

HINDS
L49
8-14-72

WATER WELL DRILLERS LOG

8/14/72 19 E.E. Jaynes firm name Forest Drilling Serv. county well located Hinds

LANDOWNER: E.E. Jaynes
Henry 18
Jackson
(mailing address)

description of formations encountered	from	to
<u>Clay and soft Rock</u>	<u>0</u>	<u>28</u>
<u>Hard B. Clay</u>	<u>28</u>	<u>103</u>
<u>Blue clay + silt + clay</u>	<u>103</u>	<u>183</u>
<u>Other fine sand + clay</u>	<u>183</u>	<u>198</u>
<u>Blue clay</u>	<u>198</u>	<u>209</u>
<u>Rock</u>	<u>209</u>	<u>210</u>
<u>Soft clay + shell</u>	<u>210</u>	<u>219</u>
<u>Blue clay</u>	<u>219</u>	<u>871</u>
<u>Other shale + lime</u>	<u>871</u>	<u>913</u>
<u>Other fine sand + shell</u>	<u>913</u>	<u>997</u>
<u>fine sand</u>	<u>997</u>	<u>1049</u>
<u>shale + other sand</u>	<u>1049</u>	<u>1062</u>

WELL LOCATION:
sec 34 T 5 R 2 E

WELL PURPOSE:
(home, irrigation, municipal, industrial)

- WELL COMPLETION DATA:
- (1) diameter (inches) 2 1/2"
 - (2) total depth (feet) 1052'
 - (3) static water level (feet) 215 below top of ground.
 - (4) casing Steel (material), 1052 (depth)
2 1/2" (size) if telescope see back.
 - (5) screen 33' (length), 1019 (depth to top)
2 1/2" (size), S. Steel (material)
 - (6) pump 5 (HP), 30 (yield gpm)
Electric (type power)
 - (7) electric log Yes (yes or no)
Miss. Geo. (organization running log)
 - (8) how well bottom plugged 2"
backwash valve


CODED

NOV 16 1972

DRILLERS REMARKS: _____

If well telescopes please sketch and show depths.

GROUND LEVEL

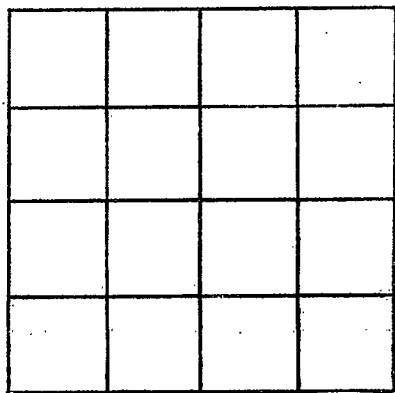

SECTION _____

Please indicate well location X.

ADDITIONAL INFORMATION

A series of horizontal lines for recording additional information, starting below the 'ADDITIONAL INFORMATION' header and extending to the bottom of the page.

If more than one screen, show locations of each on sketch.