

7  
E609 #458

HINDS  
L 51  
10-5-72

MISSISSIPPI  
BOARD OF WATER COMMISSIONERS  
416 North State Street  
Jackson, Mississippi 39201

WATER WELL DRILLERS LOG

CODED

10-5-72  
date well completed

72 SACK Bume  
firm name

Hinds  
county well located

LANDOWNER: Bob Kyle  
RAYmond  
BOB. KYLE  
(mailing address)

description of formations encountered	from	to
TOP SOIL	0	1
CLAY	1	100
S-S.	100	120
Sand	120	178
CLAY	178	190
Rock	190	220
CLAY	220	230
SAND	230	240

WELL LOCATION:  
sec. 18 T. 5 N R. 2 E  
2 miles W of RAYmond  
(distance) (direction) (nearest town)

WELL PURPOSE:  
(home, irrigation, municipal, industrial)

- WELL COMPLETION DATA:
- (1) diameter (inches) 4"
  - (2) total depth (feet) 140
  - (3) static water level (feet) 77 below above top of ground.
  - (4) casing T&C, 160 (material) (depth)  
4" (size) if telescope see back.
  - (5) screen 20 (length) (depth to top)  
2" (size) SS (material)
  - (6) pump 1 (HP) 10 (yield gpm)  
APL (type power)
  - (7) electric log Yes (yes or no)  
M.G.S. (organization running log)
  - (8) how well bottom plugged


CODED

JAN 1 9 1973

DRILLERS REMARKS:

If well telescopes please sketch and show depths.

GROUND LEVEL

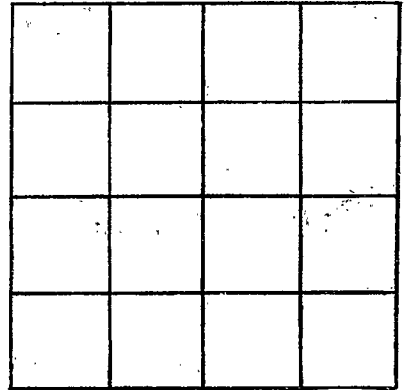

SECTION \_\_\_\_\_

Please indicate well location X.

ADDITIONAL INFORMATION

If more than one screen,  
show locations of each on sketch.