

ELOG #465

HINDS
L 53
11-17-72

MISSISSIPPI
BOARD OF WATER COMMISSIONERS
416 North State Street
Jackson, Mississippi 39201

CODED

WATER WELL DRILLERS LOG

11-17 1972 JACK Goumon Hinds
date well completed firm name county well located

LANDOWNER ROBERTS
RAYmond
PLEASE Roberts
(mailing address)

description of formations encountered	from	to
top soil	0	2
CLAY SAND	2	28
SAND	28	40
CLAY SAND	40	75
SAND	75	110

WELL LOCATION:
sec. 13 T. 5 N R. 2 E
1 miles W of Raymond
(distance) (direction) (nearest town)

WELL PURPOSE:
(home, irrigation, municipal, industrial)

- WELL COMPLETION DATA:
- (1) diameter (inches) 2 1/2"
 - (2) total depth (feet) 110
 - (3) static water level (feet) 7 below top of ground.
 - (4) casing 2 1/2 (material) 94 (depth)
if telescope see back.
 - (5) screen 101 (length) 94 (depth to top)
21 (size) 55 (material)
 - (6) pump 1 (HP) 5 (yield gpm)
EMT (type power)
 - (7) electric log yes (yes or no)
MGS (organization running log)
 - (8) how well bottom plugged BWD


CODED

JAN 19 1973

DRILLERS REMARKS:

If well telescopes please
sketch and show depths.

GROUND LEVEL

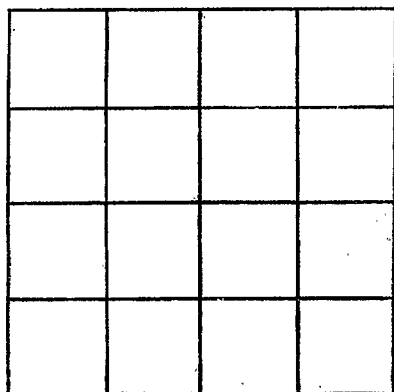

SECTION _____

Please indicate well location X.

ADDITIONAL INFORMATION

If more than one screen,
show locations of each on sketch.