

HINDS Co.

159

Eng# 609

HINDS

G-23-77

MISSISSIPPI BOARD OF WATER COMMISSIONERS
416 North State Street
Jackson, Mississippi 39201

CODED ✓

WATER WELL DRILLERS LOG

date well completed 6/23 1977 firm name Jerry Quinn Water Well Serv. county well located Hinds

LANDOWNER: DAVIS, LENON
Raymond, Ms.
(mailing address)

description of formations encountered	from	to
Clay	1	260
Stratals of Clay + Sand	261	300
Rock	301	324
Sand	325	340
Clay	341	360
Sand	361	414
Clay	415	425

WELL LOCATION:
sec. 15 T 5 N R 2 E W
5 miles NE of Raymond
(distance) (direction) (nearest town)

WELL PURPOSE: None
(home, irrigation, municipal, industrial)

- WELL COMPLETION DATA:
- (1) diameter (inches) 4
 - (2) total depth (feet) 425
 - (3) static water level (feet) 80 below top of ground.
 - (4) casing PVC 394' (material) (depth)
4" (size) if telescope see back.
 - (5) screen 20' 414' (length) (depth to top)
4" (size) PVC (material)
 - (6) pump 3/4 (HP) 10 (yield gpm)
electricity (type power)
 - (7) electric log Yes (yes or no)
Ms. Geological Survey (organization running log)
 - (8) how well bottom plugged

CODED


RECEIVED

JUL 18 1977

DRILLERS REMARKS:

If well telescopes please sketch and show depths.

GROUND LEVEL

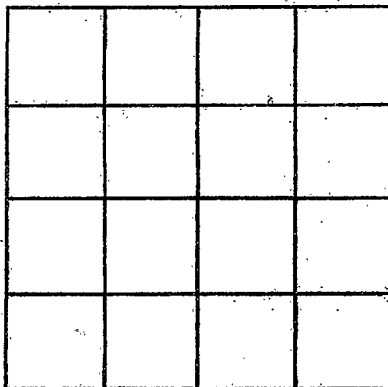

SECTION _____

Please indicate well location X:

ADDITIONAL INFORMATION

If more than one screen, show locations of each on sketch.