

HINDS
 L60
 5/10/78
 Elong #629

MISSISSIPPI
 BOARD OF WATER COMMISSIONERS
 416 North State Street
 Jackson, Mississippi 39201

CODED

WATER WELL DRILLERS LOG

5/10/78 1978 GAINOR WATER Well HINDS
 date well completed firm name county well located

LANDOWNER:
 Bennie Funches
 (mailing address)

description of formations encountered	from	to
CLAY	0	93
Rock	93	119
Sand	119	132
CLAY	132	230
Sand	230	260

WELL LOCATION:
 sec. 11 T. 5 N. R. 2 E.
 S W
 (distance) miles (direction) of (nearest town)

WELL PURPOSE:
 (home, irrigation, municipal, industrial)

WELL COMPLETION DATA:

(1) diameter (inches) 4"
 (2) total depth (feet) 254
 (3) static water level (feet) UNK below above top of ground.
 (4) casing PVC, 234, (material) (depth)
 4 (size) if telescope see back.
 (5) screen 20, 234 (length) (depth to top)
 4 (size) PVC (material)
 (6) pump 1 (HP) 10 (yield gpm)
 (type power)
 (7) electric log YES (yes or no)
 MES (organization running log)
 (8) how well bottom plugged B.W.V.

CODED


DRILLERS REMARKS:

RECEIVED
 JUL 31 1978

MISS. Bd. OF WATER COM.

If well telescopes please
sketch and show depths.

GROUND LEVEL

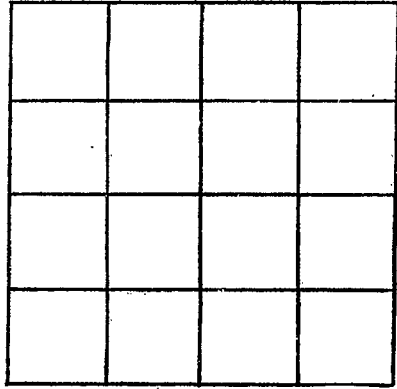

SECTION _____

Please indicate well location X.

ADDITIONAL INFORMATION

If more than one screen,
show locations of each on sketch.