

Hinds
 L64
 8-17-79
 Elog # 661

MISSISSIPPI
 BOARD OF WATER COMMISSIONERS
 416 North State Street
 Jackson, Mississippi 39201

CODED

WATER WELL DRILLERS LOG

8/17/79 1979 Jack C. Gunn General
 date well completed firm name county well located

LANDOWNER:
 W. R. Freeman
 (mailing address)

description of formations encountered	from	to
yellow clay	0	20
yellow sand	20	60
blue clay	60	90
sand	90	190
shell	190	200
sand	200	270

WELL LOCATION:
 sec. #4 T5 (N) R 2 E
 6 miles NE of Raymond
 (distance) (direction) (nearest town)

WELL PURPOSE: Domestic
 (home, irrigation, municipal, industrial)

CODED

- WELL COMPLETION DATA:
- (1) diameter (inches) 6 in.
 - (2) total depth (feet) 300 ft.
 - (3) static water level (feet) 20 ft. below top of ground.
 - (4) casing P.V.C. 130
 (material) (depth)
4 in. (size) if telescope see back.
 - (5) screen 30 ft., 130 ft.
 (length) (depth to top)
4 in. (size) P.V.C. (material)
 - (6) pump 5 (HP) 50 gal. (yield gpm)
Electric (type power)
 - (7) electric log yes (yes or no)
m. G. S. (organization running log)
 - (8) how well bottom plugged Backwash valve

Miss. Board of Water Comm.


SEP 13 1979

RECEIVED

DRILLERS REMARKS:

If well telescopes please sketch and show depths.

GROUND LEVEL

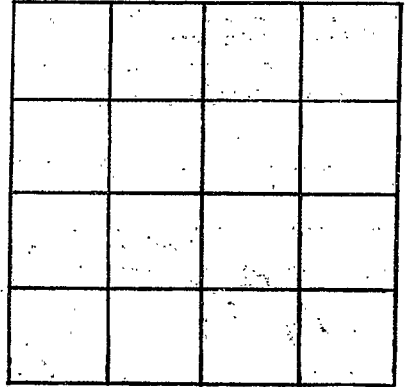

SECTION _____

Please indicate well location X.

ADDITIONAL INFORMATION

If more than one screen, show locations of each on sketch.