

Hinds
L-65
1-31-80

MISSISSIPPI
BOARD OF WATER COMMISSIONERS
416 North State Street
Jackson, Mississippi 39201

CODED

WATER WELL DRILLERS LOG

1-31-80 Griner Drilling Hinds
date well completed firm name county well located

LANDOWNER:

Getty Oil Corp.
P.O. Box 16878
Mobile, Ala. 36616
(mailing address)

description of formations encountered

from to

clay, sand, shell rock	0	231
clay, sand	231	315
clay	315	546
clay, + sand	546	630
clay	630	735
clay + sand	735	903
sand	903	1008

WELL LOCATION: 2140' + 1120' E

No. 1 Brand 11-5
sec. 11 T. 50 N. R. 2 E of Raymond, (W) Miss/Co
(distance) miles (direction) of (nearest town)

WELL PURPOSE: oil field supply
(home, irrigation, municipal, industrial)

WELL COMPLETION DATA:

- (1) diameter (inches) 3"
- (2) total depth (feet) 1008'
- (3) static water level (feet) 200' ^{below}/_{above} top of ground.
- (4) casing 1008' steel (material) (depth)
3" (size) if telescope see back.
- (5) screen 63' (length) 945' (depth to top)
3" (size) perforated (material)
- (6) pump (HP) 80 (yield gpm)
AC (type power)
- (7) electric log (yes or no)

CODED

(organization running log)

(8) how well bottom plugged orange
peel

DRILLERS REMARKS:


DEPT. OF NATURAL RESOURCES
BUREAU OF LAND & WATER RESOURCES

FEB -7 1980

RECEIVED

If well telescopes please sketch and show depths.

GROUND LEVEL

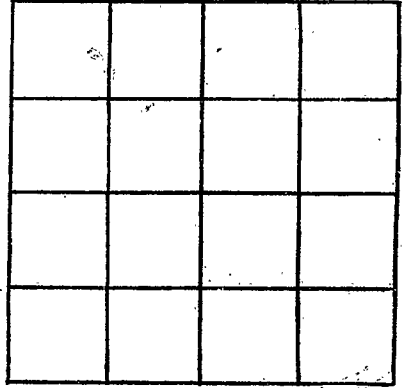

SECTION _____

Please indicate well location X.

ADDITIONAL INFORMATION

If more than one screen,
show locations of each on sketch.