

MISSISSIPPI DEPARTMENT OF NATURAL RESOURCES

Bureau of Land and Water Resources

Southport Mall

P.O. Box 10631

Jackson, Mississippi 39209

WATER WELL DRILLERS LOG

CODED

HINDS
L 67

4-3

1986 STEVE GARDNER WATER WELL

HINDS

date well completed

firm name

county well located

LANDOWNER:	description of formations encountered	from	to
JAMES HOLMES	RED SAND	0	60
(mailing address)	GRAY SAND	60	130
WELL LOCATION: sec. 13 T 5 N R E S 2 W 6 miles EAST of RAYMOND (distance) (direction) (nearest town)	SAND, CLAY SHELL	130	250
WELL PURPOSE: IRRIGATION (home, irrigation, municipal, industrial)	CLAY GOLD	250	280
WELL COMPLETION DATA:			
(1) diameter (inches) 4			
(2) total depth (feet) 280			
(3) static water level (feet) 48 below top of ground.			
(4) casing PVC, 90 (material), (depth)			
(size) if telescope see back.			
(5) screen 40, 130-90 (length), (depth to top)			
4, PVC (size), (material)			
(6) pump 1, 40 (HP), (yield gpm)			
AC (type power)			
(7) electric log YES (yes or no)			
BUREAU GEOLOGY (organization running log)			
(8) how well bottom plugged BACK WASH VAL			
DRILLERS REMARKS:			


RECEIVED

FFB 10 1987

Department of Natural Resources
Bureau of Land & Water Resources

If well telescopes please sketch and show depths.

GROUND LEVEL

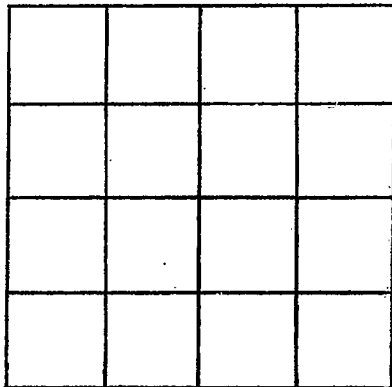

SECTION _____

Please indicate well location X.

ADDITIONAL INFORMATION

If more than one screen, show locations of each on sketch.