

HINDS

MISSISSIPPI BOARD OF WATER COMMISSIONERS

L 2001

4-62

WATER WELL DRILLERS LOG

Date: APRIL, 1962, Driller: M<sup>C</sup>NEECE DRILLING Co. County HINDS

(Name)

(1) Owner of Land: J.M. HARRISON

(Name)

Rt. 1, CLINTON MISS.

(Address)

(2) Location: NW 1/4, NE 1/4, Sec. 12, T5R2W

5 miles SW of CLINTON

(distance)

(direction)

(Nearest Town)

(3) Topography: HILLY

(Hilly)

(Flat)

(Level)

(4) Purpose of Well: DOMESTIC HOME

(Domestic Irrigation, Municipal, Industrial, Other)

Information upon completion of well:

(1) Diameter 4 1/2 inches.

(2) Total Depth 910 feet.

(3) Water Level 140 feet below top of ground.

(4) Cased to 315' 890', Size 4"

315-910' - 2"

(5) Screen: Size 2", Length 20

(6) Were any formations sealed against pollution?


yes, X no.

If YES depth of formation

Why

Drillers Remarks:

Description & Color of Materials Sand, Clay, Red Clay, Shell, etc.	Thick- ness Feet	Depth Feet
SURFACE SOIL	8	8
WHITE SHALE	11	19
SANDSTONE	9	28
GREY SHALE & SAND	17	45
GREY SHALE	21	66
SHALE & SAND	22	88
SHALE & LIGNITE	21	109
SHALE & SAND	22	131
SHALE	42	173
SHALE & SAND	22	195
SHALE	405	600
MOODY BRANCH	18	618
SHALE SAND & ROCK	14	632
SHALE & SAND	64	696
SAND & LIGNITE	22	718
SHALE & SAND	42	760
SHALE & FINE SAND	108	868
COARSE SAND	42	910

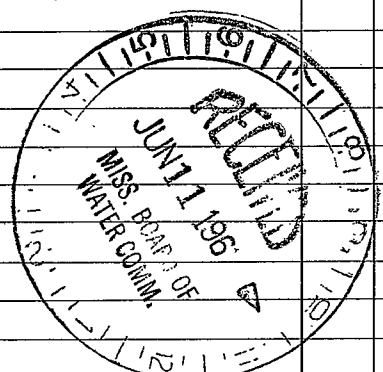

(Use Back Side)

Well No. 30