

# HINDS

## MISSISSIPPI BOARD OF WATER COMMISSIONERS

### L 2002


### 5-62

## WATER WELL DRILLERS LOG

Date: MAY, 1962, Driller: M'NEECE DRILLING Co. County HINDS

(Name)

(1) Owner of Land: <u>CHARLIE T. JENKINS</u> (Name)	Description & Color of Materials Sand, Clay, Red Clay, Shell, etc.	Thick- ness Feet	Depth Feet
<u>RT 2 Box 38, RAYMOND MISS</u> (Address)	<u>SURFACE Soil</u>	<u>12</u>	<u>12</u>
(2) Location: <u>NW 1/4</u> , <u>1/4</u> , Sec. <u>14</u> T. <u>5N</u> R. <u>2W</u>	<u>WHITE SAND</u>	<u>12</u>	<u>24</u>
<u>5</u> miles <u>NE</u> of <u>RAYMOND</u> (distance) (direction) (Nearest Town)	<u>WHITE SHALE</u>	<u>7</u>	<u>31</u>
(3) Topography: <u>HILLY</u> (Hilly) (Flat) (Level)	<u>BLACK SHALE</u>	<u>6</u>	<u>37</u>
(4) Purpose of Well: <u>DOMESTIC Home</u> (Domestic Irrigation Municipal, Industrial, Other)	<u>GREY SHALE</u>	<u>7</u>	<u>44</u>
	<u>BLACK SHALE</u>	<u>18</u>	<u>62</u>
	<u>WHITE SAND</u>	<u>6</u>	<u>68</u>
	<u>BLACK SHALE</u>	<u>19</u>	<u>87</u>
	<u>GREY SHALE</u>	<u>15</u>	<u>102</u>
	<u>ROCK LEDGES</u>	<u>38</u>	<u>140</u>
	<u>SAND &amp; SHALE</u>	<u>50</u>	<u>190</u>
	<u>FINE SAND</u>	<u>24</u>	<u>214</u>
	<u>FINE SAND</u>	<u>22</u>	<u>236</u>
	<u>COARSE SAND</u>	<u>46</u>	<u>282</u>
Information upon completion of well:			
(1) Diameter <u>3" x 2"</u> inches.			
(2) Total Depth <u>282</u> <sup><u>278</u></sup> feet.			
(3) Water Level <u>50</u> feet below top of ground.			
(4) Cased to <u>200</u> <sup><u>272</u></sup> , Size <u>3"</u> <u>200' - 282' - 2"</u>			
(5) Screen: Size <u>2"</u> , Length <u>10'</u>			
(6) Were any formations sealed against pollution?			
<u>no</u>			
If YES depth of formation _____			
Why _____			
Drillers Remarks: _____			

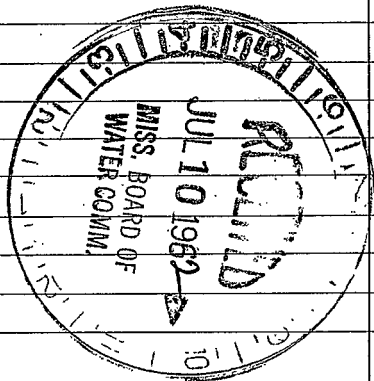

(Use Back Side)

Well No. 33