

HINDS
 L 2003
 6-62

MISSISSIPPI BOARD OF WATER COMMISSIONERS

WATER WELL DRILLERS LOG

Date: JUNE, 1962, Driller: MENECE DRILLING Co County HINDS

(Name)

(1) Owner of Land: GEORGE GILL
 (Name)

RAYMOND MISS.
 (Address)

(2) Location: SW 1/4, Sec 31 T 52 N R 2

2 1/2 miles S, of RAYMOND,
 (distance) (direction) (Nearest Town)

(3) Topography: HILLY
 (Hilly) (Flat) (Level)

(4) Purpose of Well:
 (Domestic Irrigation Municipal, Industrial, Other)

Information upon completion of well:

(1) Diameter 4" x 2" inches.

(2) Total Depth 165 feet.

(3) Water Level 74 feet below top of ground.

(4) Cased to 153' 155', Size 4"
 153' - 165' - 2"

(5) Screen: Size 2", Length 10

(6) Were any formations sealed against pollution?


yes, X no.

If YES depth of formation

Why

Drillers Remarks:

Description & Color of Materials Sand, Clay, Red Clay, Shell, etc.	Thick- ness Feet	Depth Feet
SURFACE SOIL	12	12
WHITE SAND	48	60
GREY SHALE	60	120
ROCK	8	128
SHALE	22	150
COARSE SAND	15	165

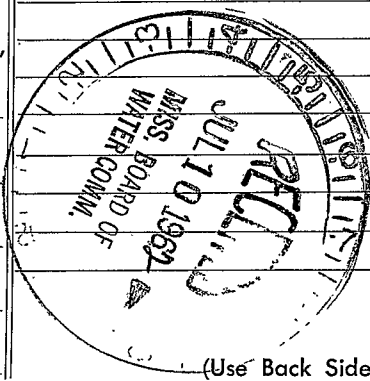

(Use Back Side)

Well No.
36