

HINDS

MISSISSIPPI BOARD OF WATER COMMISSIONERS

WATER WELL DRILLERS LOG

L 2006

5-29-64

Date: 5/29, 1964, Driller: Fred Oley Sew, County: Hinds, Miss.

(1) Owner of Land: Robert Castle
 McRaven Rd (Name)
 Jackson, Miss (Address)

(2) Location: 1/4, 1/4, Sec. T 26 R 24
 4 miles S. West of Clinton (distance) (direction) (Nearest Town)
 on McRaven Rd.

(3) Topography: (Hilly) (Flat) (Level)

(4) Purpose of Well: Domestic Home
 (Domestic Irrigation, Municipal, Industrial, Other)

Description & Color of Materials Sand, Clay, Red Clay, Shell, etc.	Thick- ness Feet	Depth Feet
Clay	0	12
1st Clay + Sand		28
1st Shale		32
2nd Fine sand + shale		112
Shale		172
1st red sand + shale		263
Shale		564
2nd rock + shale		574
Hard shale		623
Soft shale		688
1st shale + red sand		757
2nd shale, rock + fine sand		873
Sand - fine to med		899

Information upon completion of well:

(1) Diameter: 2 inches.

(2) Total Depth: 899 feet.

(3) Water Level: 150 feet below top of ground.

(4) Cased to: 884, Size: 2"


(5) Screen: Size: 2", Length: 15ft.

(6) Were any formations sealed against pollution?
 yes, no.

If YES depth of formation _____

Why _____

Drillers Remarks: _____

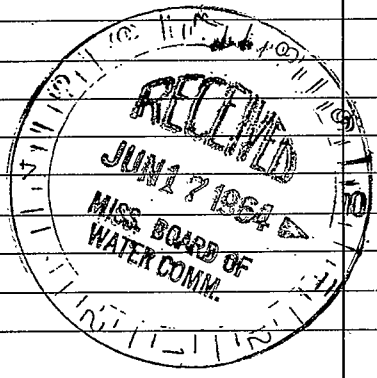

(Use Back Side)

Well No.