

HINDS MISSISSIPPI BOARD OF WATER COMMISSIONERS

L 2007  
4-15-65

WATER WELL DRILLERS LOG

Date: 4-15, 1965, Driller: ELLIS C HALL County HINDS

(Name)

(1) Owner of Land: V.S. DUNN  
(Name)  
PO BOX 1046  
JACKSON MISS  
(Address)

(2) Location: E 1/4, S.W. 1/4, Sec. 34 T14R 2W  
6 miles S.E., of RAYMOND,  
(distance) (direction) (Nearest Town)

(3) Topography: HILLY  
(Hilly) (Flat) (Level)

(4) Purpose of Well: DOMESTIC HOME  
(Domestic Irrigation  
Municipal, Industrial, Other)

Description & Color of Materials Sand, Clay, Red Clay, Shell, etc.	Thick- ness Feet	Depth Feet
<u>SURFACE SOIL</u>	<u>1</u>	<u>1</u>
<u>WHITE SAND ROCK</u>	<u>3</u>	<u>4</u>
<u>YELLOW MARL</u>	<u>16</u>	<u>20</u>
<u>GRAVEL</u>	<u>8</u>	<u>28</u>
<u>BROWN SHALE</u>	<u>54</u>	<u>82</u>
<u>SAND + SHALE</u>	<u>234</u>	<u>316</u>
<u>HARD SHALE + LIGNITE</u>	<u>20</u>	<u>336</u>
<u>SAND + SHALE</u>	<u>46</u>	<u>382</u>
<u>HARD SHALE</u>	<u>62</u>	<u>444</u>
<u>SAND (GOOD)</u>	<u>44</u>	<u>488</u>

Information upon completion of well:

(1) Diameter 4 X 2 inches.

(2) Total Depth 488 feet.

(3) Water Level 105 feet below top of ground.

(4) Cased to 300' 468', Size 4"  
148' 2"


(5) Screen: Size 2, Length 20.

(6) Were any formations sealed against pollution?  
yes, X no.

If YES depth of formation \_\_\_\_\_

Why \_\_\_\_\_

Drillers Remarks: \_\_\_\_\_

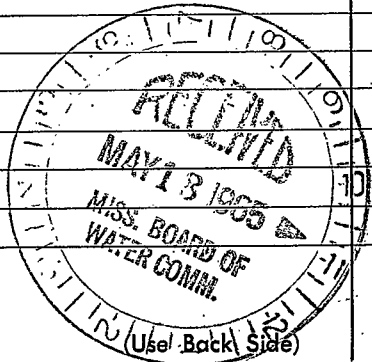

Well No. 111