

MISSISSIPPI BOARD OF WATER COMMISSIONERS

WATER WELL DRILLERS LOG

Date: 12-17, 1966, Driller: HALL DRILLING CO County HINDS

(Name)

(1) Owner of Land: CHARLES ROBERTSON  
(Name)

R1-2-BOX 167 RAYMOND  
(Address)

(2) Location: SW 1/4, SE 1/4, Sec. 11 T5R2W

6 miles NE, of RAYMOND  
(distance) (direction) (Nearest Town)

(3) Topography: HILLY  
(Hilly) (Flat) (Level)

(4) Purpose of Well: DOMESTIC HOME  
(Domestic Irrigation  
Municipal, Industrial, Other)

Description & Color of Materials  
Sand, Clay, Red Clay, Shell, etc.

Thick-  
ness  
Feet

Depth  
Feet

<u>SURFACE SOIL</u>	<u>10</u>	<u>10</u>
<u>BLACK SHALE</u>	<u>31</u>	<u>41</u>
<u>BLACK SHALE + SAND</u>	<u>31</u>	<u>72</u>
<u>ROCK LEDGES</u>	<u>33</u>	<u>108</u>
<u>SAND + SEA SHELL</u>	<u>4</u>	<u>109</u>
<u>SAND + ROCK</u>	<u>32</u>	<u>141</u>
<u>SHALE</u>	<u>34</u>	<u>176</u>
<u>FINE SAND</u>	<u>10</u>	<u>185</u>
<u>MED GRAIN SAND</u>	<u>22</u>	<u>207</u>
<u>COURSE SAND</u>	<u>20</u>	<u>227</u>


Information upon completion of well:

- (1) Diameter 7 1/2 inches.
- (2) Total Depth 227 feet.
- (3) Water Level 38 feet below top of ground.
- (4) Cased to 200', Size 4"
- (5) Screen: Size 2, Length 10'
- (6) Were any formations sealed against pollution?  
\_\_\_\_\_ yes, \_\_\_\_\_ no.

If YES depth of formation \_\_\_\_\_

Why \_\_\_\_\_

Drillers Remarks: \_\_\_\_\_

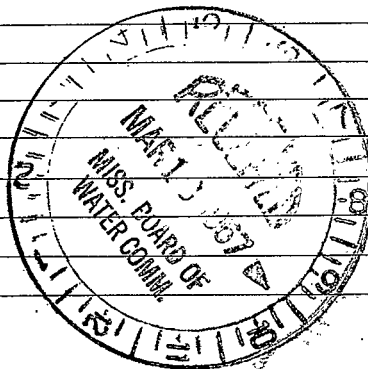

(Use Back Side)

39

Well No.