

MISSISSIPPI DEPARTMENT OF NATURAL RESOURCES

Bureau of Land and Water Resources

Southport Mall

P.O. Box 10631

Jackson, Mississippi 39209

WATER WELL DRILLERS LOG

Hinds
L 2009

2/15 1982
date well completed

82 Tom Griffith Wtr Wells
firm name

Hinds
county well located

Conductor Service, Inc.

LANDOWNER:

Jim Winstead

(mailing address)

WELL LOCATION:

sec. 11 T. 50 N. R. 2 E. W. 9
5 miles S of Jackson
(distance) (direction) (nearest town)

WELL PURPOSE: Home
(home, irrigation, municipal, industrial)

WELL COMPLETION DATA:

- (1) diameter (inches) 4"
- (2) total depth (feet) 240'
- (3) static water level (feet) 120' below above top of ground.
- (4) casing PVC, 220'
(material) (depth)
n/a if telescope see back.
(size)
- (5) screen 20', 220'
(length) (depth to top)
4", PVC
(size) (material)
- (6) pump 3/4, 10
(HP) (yield gpm)
Elec.
(type power)
- (7) electric log no
(yes or no)
n/a
(organization running log)
- (8) how well bottom plugged BWV

description of formations encountered

from

to

<u>Topsoil</u>	<u>0</u>	<u>1</u>
<u>Chalk</u>	<u>1</u>	<u>30</u>
<u>Rock & Chalk</u>	<u>30</u>	<u>95</u>
<u>Rock</u>	<u>95</u>	<u>110</u>
<u>Sand & Rock</u>	<u>110</u>	<u>180</u>
<u>Sand</u>	<u>180</u>	<u>240</u>

DRILLERS REMARKS:


DEPT. OF NATURAL RESOURCES
BUREAU OF LAND & WATER RESOURCES

DEC - 1 1982

RECEIVED

If well telescopes please sketch and show depths.

GROUND LEVEL

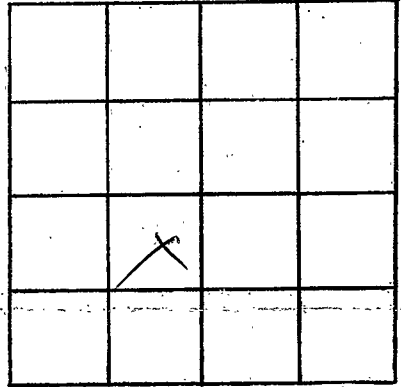

SECTION _____

Please indicate well location X.

ADDITIONAL INFORMATION

If more than one screen, show locations of each on sketch.