

M 302

M

WATER WELL DRILLERS LOG

4-61

Date: APRIL, 1961, Driller: McNEECE DRILLING CO. County HINDS

(Name)

(1) Owner of Land: K.M. STROUD  
(Name)

1401 McDOWELL, JACKSON MISS.  
(Address)

(2) Location: NW NE 38 5 1/4 1/4 Sec. 38 T. 5 R. 1 W.  
(Address) (Section) (Township) (Range)

8 miles WEST of JACKSON  
(distance) (direction) (Nearest Town)

(3) Topography: Hilly  
(Hilly) (Flat) (Level)

(4) Purpose of Well: DOMESTIC  
(Domestic Irrigation) (Municipal, Industrial, Other)

Description & Color of Materials Sand, Clay, Red Clay, Shell, etc.	Thick- ness Feet	Depth Feet
CLAY SOIL	12	0
WHITE SHALE	18	30
ROCK LEDGES	40	70
SANDY SHALE	84	154
FINE SAND	14	168
FINE SAND & SHALE	19	187
GREY SHALE	405	592
ROCK	4	596
SAND & SHALE	19	615
SHALE	42	657
FINE SAND & SHALE	21	678
SAND	44	722

Information upon completion of well:

(1) Diameter 4 X 2 inches.

(2) Total Depth 722 feet.

(3) Water Level 209 feet below top of ground.

(4) Cased to 325, Size 4"  
325-722 - 2"


(5) Screen: Size 2, Length 20

(6) Were any formations sealed against pollution?  
no

If YES depth of formation \_\_\_\_\_

Why \_\_\_\_\_

Drillers Remarks: \_\_\_\_\_

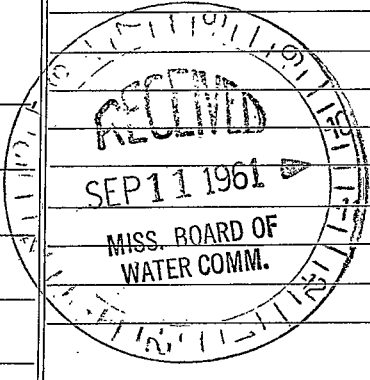

(Use Back Side)

Well No. 13