

HINDS MISSISSIPPI BOARD OF WATER COMMISSIONERS
 M-63 Elect Log Miss. Geological Survey
WATER WELL DRILLERS LOG

Date: 2-11-, 1965, Driller: James McNEES County Hinds
 (Name)

(1) Owner of Land: W.C. Deveney
 (Name)
JACKSON MISS
 (Address)
Spring Ridge Road 372-6703
 (2) Location: 1/4, 1/4, Sec. 18 T5R1
8 miles west of Jackson
 (distance) (direction) (Nearest Town)
 (3) Topography: (Hilly) (Flat) (Level)
 (4) Purpose of Well: Domestic
 (Domestic Irrigation, Municipal, Industrial, Other)


Description & Color of Materials Sand, Clay, Red Clay, Shell, etc.	Thick- ness Feet	Depth Feet
Surface Soil	10	10
Blue shale	40	50
Blue shale sd strk	40	90
SEND	20	120
Grey sh	3	123
Grey sh sd strk Limit	40	163
SEND	17	180
Grey sdy sh	3	183
Grey shale	462	645
sd sh	20	665
Grey sh sd strk	112	777
SEND	74	851
SEND sh strk	20	871

Information upon completion of well:

(1) Diameter 4" x 2" inches.
 (2) Total Depth 871 feet.
 (3) Water Level 157 feet below top of ground.
 (4) Cased to 766', Size 4" x 2"
 (5) Screen: Size 2" 008, Length 20
 (6) Were any formations sealed against pollution?
 yes, no.

16 1/2 4"	327	4
1 4" x 2" swedge	1	
20 1/2 2"	338	4
1 - -	422	
	6	
3-2' 008 sss	766	4
	30	
	796	4
1-1 1/2 2" BPV	8	8
	805	0

If YES depth of formation _____
 Why _____
 Drillers Remarks: _____

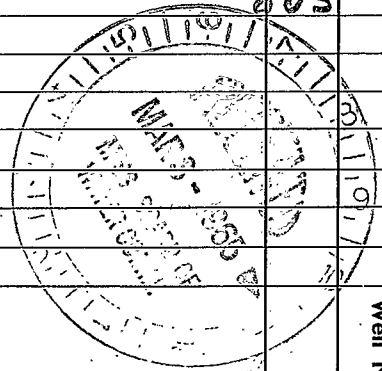

(Use Back Side)

Well No.