

HINDS

M 74

M 301

8-2-61

WATER WELL DRILLERS LOG

Date: AUG. 2, 1961, Driller: McNEECE DRILLING CO. County HINDS

(Name)

(1) Owner of Land: C.O. MILLER
(Name)

McRAVEN RD. JACKSON MISS.
(Address)

(2) Location: NW 1/4, 1/4, Sec. 8 T. 5 R. 11
2 miles SOUTH of CLINTON
(distance) (direction) (Nearest Town)

(3) Topography: HILLY
(Hilly) (Flat) (Level)

(4) Purpose of Well: DOMESTIC
(Domestic Irrigation
Municipal, Industrial, Other)

Description & Color of Materials Sand, Clay, Red Clay, Shell, etc.	Thick- ness Feet	Depth :Feet
TOP SOIL	6	0
RED SAND	90	96
GREY SHAKE	494	590
SAND + SHAKE + SHELL	24	614
SHAKE	29	633
SHALY SAND	37	670
SAND	8	678
SHALY SAND	12	690
SAND	10	700
SHALY SAND	45	745
SAND	15	760
SHALY SAND	100	860

Information upon completion of well:

(1) Diameter 4 1/2 inches.

(2) Total Depth 860 feet.

(3) Water Level 275 feet below top of ground.

(4) Cased to 408', Size 4"
408' - 860' - 2"


(5) Screen: Size 2", Length 30'

(6) Were any formations sealed against pollution?
no

If YES depth of formation _____

Why _____

Drillers Remarks: _____

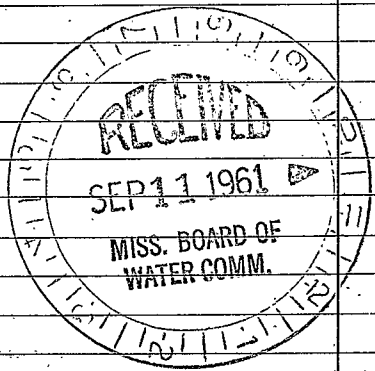

(Use Back Side)

Well No. 18