

HINDS
M77

2-1-63

WATER WELL DRILLERS LOG

CODED

Date: 2-1-63, 19___, Driller: James McNeese County Hinds

(Name)

(1) Owner of Land: J.W. Moore
(Name)
Raymond Road.
(Address)

(2) Location: NE 1/4, SW 1/4, Sec. 28 5th R1W
6 miles West, of Jackson
(distance) (direction) (Nearest Town)

(3) Topography: (Level)
(Hilly) (Flat)

(4) Purpose of Well: Domestic
(Domestic Irrigation
Municipal, Industrial, Other)

Description & Color of Materials Sand, Clay, Red Clay, Shell, etc.	Thick- ness Feet	Depth Feet
Surface soil	30	30
Rock	30	60
Grey sdy shale	40	100
Sand	30	130
Grey shale	485	615
Grey sdy sh	25	640
Grey shale	47	687
Sand	63	750
Grey shale	21	771

Information upon completion of well:

(1) Diameter 4" x 2" inches.

(2) Total Depth 771 feet.

(3) Water Level 186 feet below top of ground.

(4) Cased to 724, Size 4" x 2"

(5) Screen: Size 2" 10, Length 008-20'


(6) Were any formations sealed against pollution?
_____ yes, no.

15 Joints 4"	315'
1 4" x 2" swedge	1
19 Joints 2"	399
1 - - -	9
	724
1- 2" 007 ss screen	10
1- 2" Blank nipple	2
1- 2" 008 ss screen	10
	746
1- 2" Tail pipe and B.P.V	5
	751'

If YES depth of formation _____

Why _____

Drillers Remarks: _____

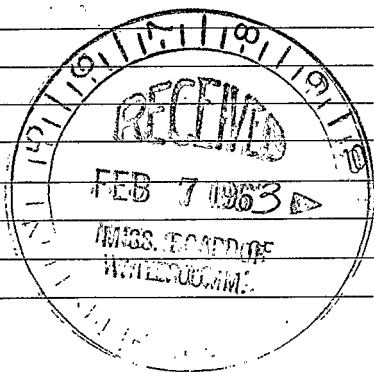

(Use Back Side)

Well No.