

HINDS  
M 79  
5-64

MISSISSIPPI BOARD OF WATER COMMISSIONERS

WATER WELL DRILLERS LOG CODED

R.G

Date: MAY, 1964, Driller: MCNEECE County HINDS

E log # 193

(Name)

(1) Owner of Land: EE. JOYNER  
(Name)

RT. 1, JACKSON MISS  
(Address)

(2) Location: 1/4, SW 1/4, Sec. 32, T. 1 N, R. 1 W  
6 miles SE, of RAYMOND  
(distance) (direction) (Nearest Town)

(3) Topography: FLAT  
(Hilly) (Flat) (Level)

(4) Purpose of Well: DOMESTIC  
(Domestic Irrigation  
Municipal, Industrial, Other)

Description & Color of Materials Sand, Clay, Red Clay, Shell, etc.	Thick- ness Feet	Depth Feet
SURFACE SOIL	6	6
WHITE SHALE	18	24
SHALE & SAND	14	38
GREY SHALE	62	100
ROCK LEDGES	57	157
SHALE & SAND	76	233
SHALE	21	254
SHALE & SAND	22	276
SAND	28	304
SHALE	416	720
ROCK	5	725
SHALE SHELL & SAND	26	751
SHALE & SAND	56	807
SAND	76	883
SHALE	7	890
CODED		

Information upon completion of well:

(1) Diameter 4x2 inches.

(2) Total Depth 890 feet.

(3) Water Level 185 feet below top of ground.

(4) Cased to 354', Size 4"  
354' to 890' - 2"


(5) Screen: Size 2", Length 20'

(6) Were any formations sealed against pollution?  
yes, X no.

If YES depth of formation \_\_\_\_\_

Why \_\_\_\_\_

Drillers Remarks: \_\_\_\_\_

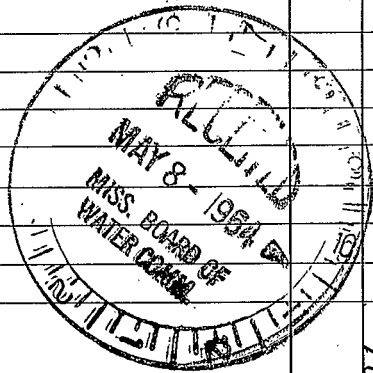

(Use Back Side)

Well No. 70