

HINDS  
M81

MISSISSIPPI BOARD OF WATER COMMISSIONERS

ELOG # 206

3-16-65

WATER WELL DRILLERS LOG

CODED

Date: 3-16, 1965, Driller: ELLIS C HALL County HINDS  
HALL DRILLING CO

(1) Owner of Land: HC. ROKKETT  
(Name)  
3805 NORTHVIEW DR  
JACKSON MISS  
(Address)

(2) Location: SE 1/4, SW 1/4, Sec. 29 T5R12E  
10 miles W, of JACKSON  
(distance) (direction) (Nearest Town)

(3) Topography: FLAT  
(Hilly) (Flat) (Level)

(4) Purpose of Well: MUNICIPAL  
(Domestic Irrigation  
Municipal, Industrial, Other)

Description & Color of Materials Sand, Clay, Red Clay, Shell, etc.	Thick- ness Feet	Depth Feet
SURFACE SOIL	4	4
LIGHT BROWN MARL	16	20
DARK BROWN MARL		
W/SEA SHELL	43	63
ROCK LEDGES	39	102
SAND + SEA SHELL	20	122
GREY SAND (FINE)	20	142
SAND + LIGNITE	87	229
SAND (GOOD)	20	240
SAND + LIGNITE	31	271
SHALE	22	293
SAND + SHALE	43	336
SAND (GOOD)	43	379
YAZOO CLAY	340	719
MOOPY BRANCH	20	739
SAND SHALE + LIGNITE	241	980
SAND (GOOD)	43	1023
SAND + LIGNITE	12	1035
SHALE + GUMBO	83	1118

Information upon completion of well:

(1) Diameter 4 X 2 1/2 inches.

(2) Total Depth 1118 feet.

(3) Water Level 220 feet below top of ground.

(4) Cased to 400', Size 4'  
748' 2 1/2


(5) Screen: Size 2 1/2, Length 40

(6) Were any formations sealed against pollution?  
\_\_\_\_\_ yes, X no.

If YES depth of formation \_\_\_\_\_

Why \_\_\_\_\_

Drillers Remarks: \_\_\_\_\_

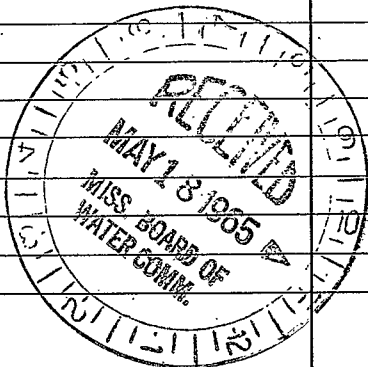

(Use Back Side)

Well No. 9