

HINDS

MISSISSIPPI BOARD OF WATER COMMISSIONERS

ELOG # 224

M 586

Electrical Log - Miss-Geological Survey

7-23-65

WATER WELL DRILLERS LOG

CODED

Date: 7-27-1965, Driller: James McNEES County: HINDS

(Name)

(1) Owner of Land: J. W. Graham (Name)
Raymond Road Jackson (Address)

(2) Location: 1/4, 1/4, Sec. 19 T5 R1,
6 miles West of Jackson (distance) (direction) (Nearest Town)

(3) Topography: (Hilly) (Flat) (Level)

(4) Purpose of Well: Domestic (Domestic Irrigation, Municipal, Industrial, Other)

Description & Color of Materials Sand, Clay, Red Clay, Shell, etc.	Thick- ness Feet	Depth Feet
SUIFZER SOIL	10	10
CLAY	50	60
Rock sh strks	35	95
Grey shale	25	120
SAND	10	130
Grey sdy sh	50	180
Grey shale	20	200
Grey sh sd strks	20	220
SAND	10	230
Grey shale	449	679
SAND sh strks	86	765
SAND	9	774
SAND sh strks	15	789
Grey sh	7	796
SAND	13	809
Grey sdy sh	62	871
16 Hts 4"	338	
1 4"x2" Swedoe	1	
	339	
20 Hts 2"	419	
	758	
1-10'-2" .008 sss	10	
	768	
1-11'2"	21	
1 - -	11	
	00	
1-10'-2" .008 sss	10	
	86	
1-11'2"	21	
	107	

Information upon completion of well:

(1) Diameter: 4" x 2" inches.

(2) Total Depth: 871 feet.

(3) Water Level: 203 feet below top of ground.

(4) Cased to: 758', Size: 4" x 2"


(5) Screen: Size: 2.008, Length: 20'

(6) Were any formations sealed against pollution?
yes, no.

If YES depth of formation

Why

Drillers Remarks: Water White

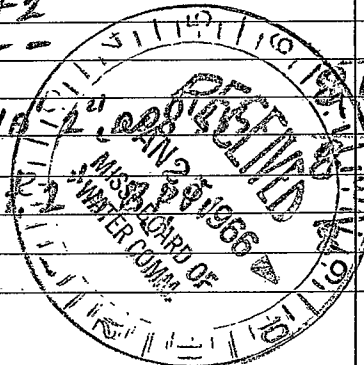

(Use Back Side)

Well No.