

Hinds
M 90
9-65

MISSISSIPPI BOARD OF WATER COMMISSIONERS

ELOG # 234

WATER WELL DRILLERS LOG

CODED

Date: 9-21, 1965, Driller: HALL DRILLING CO County HINDS

(Name)

(1) Owner of Land: HINDS COUNTY WATER CO
(Name)
P.O. BOX 8127 JACKSON MISS
(Address)

(2) Location: NE 1/4, 1/4, Sec. 29 T5N R1W,
2 1/2 miles WEST, of FORRESTHILL
(distance) (direction) (Nearest Town)

(3) Topography: HILLY
(Hilly) (Flat) (Level)

(4) Purpose of Well: MUNICIPAL
(Domestic Irrigation
Municipal, Industrial, Other)

Description & Color of Materials Sand, Clay, Red Clay, Shell, etc.	Thick- ness Feet	Depth Feet
SURFACE SOIL	6	6
GREY MARL	14	20
BROWN SH + SAND + ROCK	22	42
ROCK LEDGES	43	85
SAND + SHALE	172	257
YAZOO CLAY	411	668
MOODY BRANCH	10	678
SHALE	47	725
FINE SAND	20	745
GOOD SAND	38	783
SHALE	13	796
SAND	32	828
SAND + SHALE	30	858
HARD SHALE	100	958
SAND SHALE + LIENITE	70	1028
ROCK + SHALE C.M.	108	1136
20' 2 1/2" SCREEN AT 750 TO 770		
20' 2 1/2" " " 800 TO 820		

Information upon completion of well:

(1) Diameter 4 X 2 1/2 inches.

(2) Total Depth 1136 feet.

(3) Water Level 201 feet below top of ground.

(4) Cased to 900, Size 4"
388 2 1/2"


(5) Screen: Size 2 1/2", Length 40'

(6) Were any formations sealed against pollution?
yes, X no.

If YES depth of formation _____

Why _____

Drillers Remarks: _____

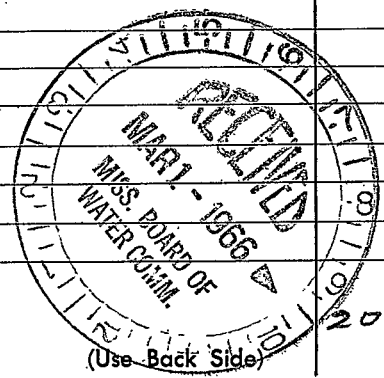

Well No. 20