

HINDS MISSISSIPPI BOARD OF WATER COMMISSIONERS

M91

5-10-66

WATER WELL DRILLERS LOG

Date: 5-10, 1966, Driller: HALL DRILLING CO County HINDS

(Name)

(1) Owner of Land: JOHN HEIDEN
(Name)

RT 1. JACKSON MISS
(Address)

(2) Location: SW 1/4, S 1/4, Sec. 29 T8N R1W

9 miles WEST, of JACKSON,
(distance) (direction) (Nearest Town)

(3) Topography: FLAT
(Hilly) (Flat) (Level)

(4) Purpose of Well: DOMESTIC HOME
(Domestic Irrigation
Municipal, Industrial, Other)

Description & Color of Materials Sand, Clay, Red Clay, Shell, etc.	Thick- ness Feet	Depth Feet
<u>SURFACE SOIL</u>	<u>10</u>	<u>10</u>
<u>WHITE MARL</u>	<u>10</u>	<u>20</u>
<u>WHITE SAND</u>	<u>7</u>	<u>27</u>
<u>BROWN SHALE</u>	<u>88</u>	<u>115</u>
<u>ROCK LEDGES</u>	<u>40</u>	<u>155</u>
<u>SAND-SEA SHELL</u>	<u>5</u>	<u>160</u>
<u>SHALE & SAND</u>	<u>113</u>	<u>273</u>
<u>MED GRAIN SAND</u>	<u>26</u>	<u>299</u>
<u>VAZOO CLAY</u>	<u>418</u>	<u>717</u>
<u>MOODY BRANCH</u>	<u>16</u>	<u>733</u>
<u>SAND & SHALE & LIM</u>	<u>90</u>	<u>823</u>
<u>COURSE SAND &</u>	<u>-</u>	<u>-</u>
<u>HARD SHALE STRATA</u>	<u>33</u>	<u>856</u>

Information upon completion of well:

(1) Diameter 4X2 inches.

(2) Total Depth 856 feet.

(3) Water Level 201 feet below top of ground.

(4) Cased to _____, Size _____

(5) Screen: Size _____, Length _____


(6) Were any formations sealed against pollution?

_____ yes, X no.

If YES depth of formation _____

Why _____

Drillers Remarks: _____

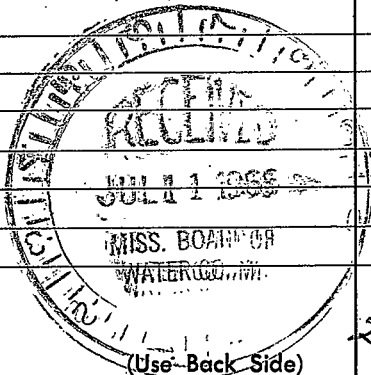

(Use Back Side)

Well No. 28