

Hinds
 M 94
 8-28-68
 Schlumberger
 8-28

MISSISSIPPI
 BOARD OF WATER COMMISSIONERS
 416 North State Street
 Jackson, Mississippi 39201

CODED

WATER WELL DRILLERS LOG

1968 Layne-Central Company Hinds
 date well completed firm name county well located

LANDOWNER:
Metropolitan Water, Inc.
Jackson, Miss.
 (mailing address)

WELL LOCATION: Forest Hill Road
 sec. 26 T 5 N R 1 E
 (distance) miles of (direction) of (nearest town)

WELL PURPOSE: Domestic
 (home, irrigation, municipal, industrial)

description of formations encountered	from	to
Clay	0	35
Blue Clay	35	430
Clay & Sand Strata	430	485
Sandy Clay	485	648
Clay Strata of Sand	648	730
Hard Clay Rock Strata	730	898
Sandy Shale	898	1014
Shale	1014	1110
Sandy Shale	1110	1190
Shale	1190	1310

WELL COMPLETION DATA:

(1) diameter (inches) 16"

(2) total depth (feet) 1095'

(3) static water level (feet) 225' below above top of ground.

(4) casing steel, 1009'
 (material) (depth)
 (size) if telescope see back.

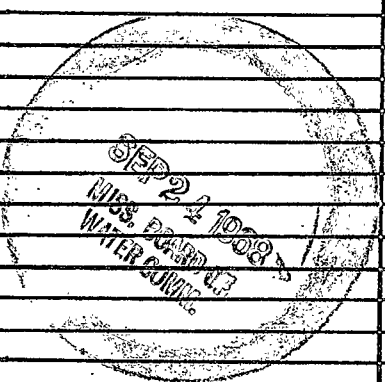
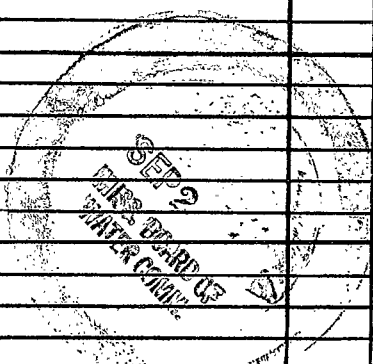
(5) screen 65', 1014'
 (length) (depth to top)
8", Stainless Steel
 (size) (material)

(6) pump 150³
 (HP) (yield gpm)
Electric
 (type power)

(7) electric log yes
 (yes or no)
Schlumberger
 (organization running log)

(8) how well bottom plugged _____

CODED

DRILLERS REMARKS: Pump Not installed as of this date.

If well telescopes please sketch and show depths.

GROUND LEVEL

SECTION _____

Please indicate well location X.

ADDITIONAL INFORMATION

If more than one screen, show locations of each on sketch.