

ELOG # 309

*Codey*

Hinds  
M 96  
1-16-69

MISSISSIPPI  
BOARD OF WATER COMMISSIONERS  
416 North State Street  
Jackson, Mississippi 39201

WATER WELL DRILLERS LOG

1-16-69 James D McNeese Hinds

date well completed

firm name

county well located

LANDOWNER:

Dr. Lloyd G. Berrong  
M<sup>c</sup>Farland Road Jackson  
(mailing address)

description of formations encountered

from to

Surface soil	0	5
CLAY	5	25
Blue shale	25	170
Grey sdy sh	170	189
ROCK	189	226
Grey sh	226	244
Grey sdy sh	244	280
Grey sh	280	325
S2NG	325	335
Grey sdy sh	335	350
S2NG	350	370
Grey sh	370	385

WELL LOCATION:

sec. 305 N R 1 E  
8 miles West of Jackson  
(distance) (direction) (nearest town)

WELL PURPOSE:

Home  
(home, irrigation, municipal, industrial)

WELL COMPLETION DATA:

(1) diameter (inches) 2

(2) total depth (feet) 385

(3) static water level (feet) 118 below above top of ground.

(4) casing Steel 354  
(material) (depth)

(size) if telescope see back.

(5) screen 15' 354  
(length) (depth to top)

2" 007 stainless steel  
(size) (material)

(6) pump 5 20  
(HP) (yield gpm)

Air compressor  
(type power)

(7) electric log yes  
(yes or no)

M.C.S.  
(organization running log)

(8) how well bottom plugged mod

17 1/2" 2" 354  
15" 2" 007  
stainless steel  
screen 15'  
369

*Codey*

JAN 21 1969


MISS. BD. OF WATER COMM.

DRILLERS REMARKS:

No color

If well telescopes please sketch and show depths.

GROUND-LEVEL

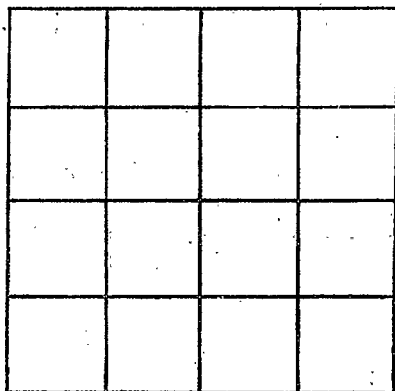

SECTION 30

Please indicate well location X.

ADDITIONAL INFORMATION

If more than one screen, show locations of each on sketch.