

HINDS
 MPT
 9-15-68

MISSISSIPPI
 BOARD OF WATER COMMISSIONERS
 416 North State Street
 Jackson, Mississippi 39201

CODED

WATER WELL DRILLERS LOG

9-15 1968 LRPITTS HINDS
 date well completed firm name county well located

LANDOWNER: MO E. Henry

description of formations encountered	from	to
---------------------------------------	------	----

Jackson
 (mailing address)

TOP SOIL	0	10
CLAY WITH SOME SAND	10	30
BLUE CLAY	30	65
WHITE CLAY	65	75
SHALE STR SAND FIN	75	240
BLUE CLAY	240	465
ROCK	465	470
CLAY	470	600
ROCK	600	604
SHALE	604	640
STRY SHALE	640	780
SANDY SHALE	780	890
SAND FINE	890	900
SAND MED TO COV	900	940

WELL LOCATION:
 sec 30 T. 5 N. R. 1 E. S. 5
5 miles E of RAYMOND
 (distance) (direction) (nearest town)

WELL PURPOSE: HOME
 (home, irrigation, municipal, industrial)

WELL COMPLETION DATA:

- (1) diameter (inches) 4 X 2
- (2) total depth (feet) 940
- (3) static water level (feet) 184 below above top of ground.
- (4) casing Steel, 930
 (material) (depth)
 (size) If telescope see back.
- (5) screen 10, 930
 (length) (depth to top)
2, Stainless Steel
 (size) (material)
- (6) pump 1, 10
 (HP) (yield gpm)
Ellie
 (type power)
- (7) electric log NO
 (yes or no)
- (organization running log)
- (8) how well bottom plugged B.P. Valve

CODED

JUL 21 1968


Misc. Bd. OF
 WATER COMM.

CODED

DRILLERS REMARKS:

If well telescopes please sketch and show depths.

GROUND LEVEL

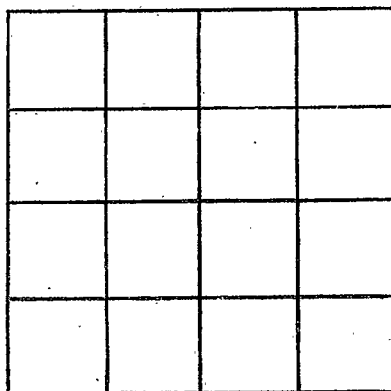

SECTION _____

Please indicate well location X.

ADDITIONAL INFORMATION

If more than one screen, show locations of each on sketch.