

Hinds  
M98

9-23-69

MISSISSIPPI  
BOARD OF WATER COMMISSIONERS  
416 North State Street  
Jackson, Mississippi 39201

CODED

WATER WELL DRILLERS LOG

date well completed 9/23 1969 firm name Forest Drilling county well located Hinds

LANDOWNER:

Spaulding, Mrs. E. M.  
Box 79 Jackson, Miss.  
(mailing address)

WELL LOCATION:

sec. 21 T. 5 N. R. 1 E. W. 5  
(distance) miles (direction) of Clinton  
(nearest town)

WELL PURPOSE:

home  
(home, irrigation, municipal, industrial)

WELL COMPLETION DATA:

- (1) diameter (inches) 2"
- (2) total depth (feet) 702'
- (3) static water level (feet) 210' below top of ground.
- (4) casing Galv. 687'  
(material) (depth)  
2" if telescope see back.  
(size)
- (5) screen 15' 687'  
(length) (depth to top)  
2" stainless steel  
(size) (material)
- (6) pump 5 HP 15  
(HP) (yield gpm)  
Electric  
(type power)
- (7) electric log yes  
(yes or no)  
7/17/69  
(organization running log)
- (8) how well bottom plugged 2" Standard Valve

description of formations encountered

from

to


Brown clay	0	20
clay & rock	20	34
clay & musky sand	34	42
clay	42	53
clay & musky sand	53	61
clay & silt	61	81
clay	81	122
clay & silt fine sand	122	166
shale	166	389
shale	389	491
shale & silt rock	491	512
shale	512	573
soft shale	573	615
shale	615	635
shale & silt fine sand	635	655
clay & fine sand	655	695
fine sand	695	700
shale	700	715
soft shale	715	835
shale	835	878
shale & silt fine sand	878	899
shale	899	930
shale & silt	930	940
shale	940	982

DRILLERS REMARKS:

MISS. BD. OF  
WATER COMM.

If well telescopes please sketch and show depths.

GROUND LEVEL

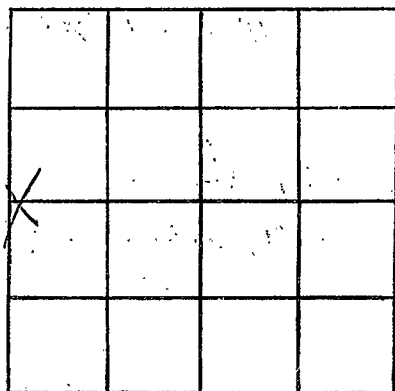

SECTION 21

Please indicate well location X.

ADDITIONAL INFORMATION

If more than one screen,  
show locations of each on sketch.