

OW 7702

MISSISSIPPI
BOARD OF WATER COMMISSIONERS
416 North State Street
Jackson, Mississippi 39201

Log # 422

Hinds
M-99
6-68
Schlumberger

WATER WELL DRILLERS LOG

6-26-1968 date well completed
Layne Central Co firm name
Hinds county well located

LANDOWNER:

Metropolitan Water, Inc.

description of formations encountered

from to

Jackson, Miss.
(mailing address)

Red Clay 0 5

WELL LOCATION: T. V. Road

sec. 15 T 5 N R 1 E

Yellow Clay 5 25

miles of (distance) (direction) (nearest town)

Blue Clay 25 315

WELL PURPOSE: Domestic
(home, irrigation, municipal, industrial)

Hard Gummy Shale 315 406

WELL COMPLETION DATA:

(1) diameter (inches) 16"

Sandy Shale 406 543

(2) total depth (feet) 1126'

Fine Sand + Shale 543 612

(3) static water level (feet) 251' below top of ground.

Sandy Shale + Lignite 612 681

(4) casing Steel 1054' (material) (depth)

Shale + Sandy streaks 681 716

16" (size) if telescope see back.

Rock 716 717

(5) screen 65' 1054' (length) (depth to/top)

Gummy Shale 717 769

8 Stainless Steel (size) (material)

Lime Rock 769 772

(6) pump (HP) (yield gpm)

Shale 772 780

Electric (type power)

Rock 780 783

(7) electric log Yes (yes or no)

Shale 783 816

Schlumberger (organization running log)

Sandy Shale + Stks. Lignite 816 951

(8) how well bottom plugged Valve

Shale Stks. Fine Sand 951 1019

DRILLERS REMARKS:


Pump not installed as of this date

Fine Sand + Shale 1019 1045

MISS. Bd. of WATER COMMISSIONERS

If well telescopes please sketch and show depths.

GROUND LEVEL

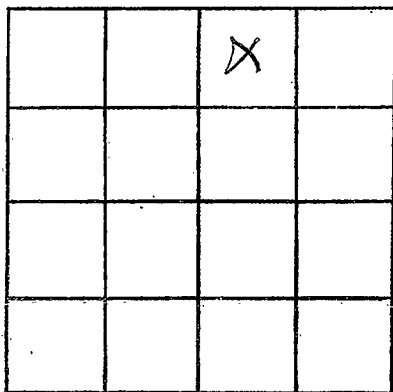

SECTION 15

Please indicate well location X.

ADDITIONAL INFORMATION

Lined area for additional information.

If more than one screen, show locations of each on sketch.