

Elc by 324

MISSISSIPPI BOARD OF WATER COMMISSIONERS

CODED

416 North State Street
Jackson, Mississippi 39201

WATER WELL DRILLERS LOG

Hinds
M. 101
9-18-69

9/18 1969 Forest Drilling Hinds
date well completed firm name county well located

LANDOWNER:
Hick, W. A.
Rt. 1, Box 3, Jackson, Miss.
(mailing address)

WELL LOCATION:
sec. 5 T. 5 N. R. 1 E
2 miles S of Clifton
(distance) (direction) (nearest town)

WELL PURPOSE: Home
(home, irrigation, municipal, industrial)

WELL COMPLETION DATA:

- (1) diameter (inches) 2"
- (2) total depth (feet) 571'
- (3) static water level (feet) 170' below top of ground.
- (4) casing (material) (depth) 551'
- (5) screen (size) (length) (depth to top) 2" (15' - #8) 20' 551'
- (6) pump (HP) (yield gpm) 5HP 20
(type power) Elect
- (7) electric log (yes or no) yes
(organization running log) U. of. Geological
- (8) how well bottom plugged 3" Backwash Valve

description of formations encountered	from	to
Clay	0	29
Blue clay	29	245
shale	245	408
sandy shale + rock	408	430
shale	430	461
shale + silts fine sand	461	471
dirt sand	471	491
dirt	491	501
fine sand + silts shale	501	553
fine sand	553	560
shale	560	564
fine sand	564	569
shale	569	594

CODED

OCT 2 - 1969


MISS. BD. OF WATER COMMISSIONERS

DRILLERS REMARKS:

mit sand

If well telescopes please sketch and show depths.

GROUND LEVEL

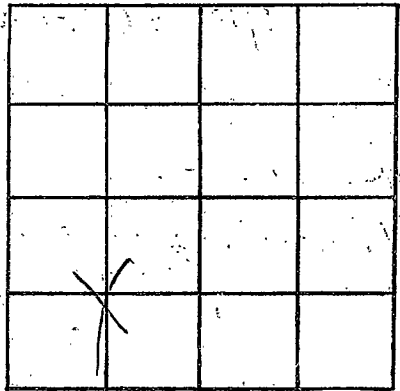

SECTION 5

Please indicate well location X.

ADDITIONAL INFORMATION

If more than one screen, show locations of each on sketch.