

HINDS
M105
11-12-72
CW 02703

ELOG #460

MISSISSIPPI
BOARD OF WATER COMMISSIONERS
416 North State Street
Jackson, Mississippi 39201

WATER WELL DRILLERS LOG

CODED
Hinds

11/12 1972 Singar Luma Central Div. Hinds
date well completed USGS Log Well name county well located

LANDOWNER: Cedar Hill Sub
Wertman & Mann, Inc.
Jackson, Miss.
(mailing address)

description of formations encountered	from	to
Sandy Red Clay	0	10
Yellow Clay	10	25
Sandy Clay & Lignite	25	30
Brittle Clay	30	298
Hard Clay	298	487
Sandy Clay	487	552
Sand & Shale (Streaks)	552	602
Clay	602	610
Sandy Clay	610	617
Sand & Shale (Streaks)	617	675
Sandy Clay	675	686
Sand & Shale (Streaks)	686	728
Sandy Shale	728	776
Hard Clay	776	820
Rock	820	821
Hard Clay	821	867
Rock	867	868
Clay	868	872
Rock	872	874
Hard Clay	874	881
Rock	881	882
Clay	882	887
Rock	887	888
Hard Shale	888	910
Rock	910	913
Shales	913	915
Rock	915	917
Sandy Shale	917	1050
Shale & Sand (Streaks)	1050	1135
Shale	1135	1148
Sand	1148	1250
Sandy Shale	1250	1257

WELL LOCATION:
sec. 22 T. 5 N R. 1 W
miles (distance) of (direction) (nearest town)

WELL PURPOSE: Domestic
(home, irrigation, municipal, industrial)

WELL COMPLETION DATA:
(1) diameter (inches) 16"
(2) total depth (feet) 1252'
(3) static water level (feet) 223' below top of ground.
(4) casing Steel 1186' (material) (depth)
16" (size) if telescope see back.
65' 11" 8"
(5) screen 60' 1186' (length) (depth to top)
8" Stainless Steel (size) (material)
(6) pump 100 (HP) 500 (yield gpm)
Electric (type power)
(7) electric log yes (yes or no)
Miss. Geo. Survey (organization running log)
(8) how well bottom plugged Valve


CODED

DRILLERS REMARKS:

NOV 17 1972

If well telescopes please sketch and show depths.

GROUND LEVEL

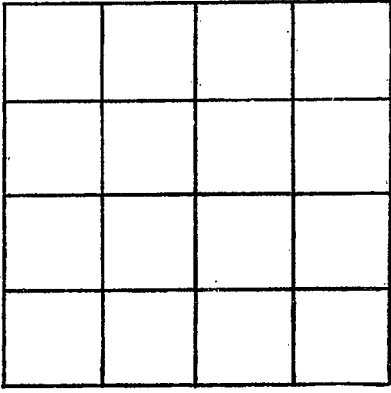

SECTION _____

Please indicate well location X.

ADDITIONAL INFORMATION

A series of horizontal lines for recording additional information.

If more than one screen, show locations of each on sketch.