

HINDS
M106
7-13-73
log # 519

MISSISSIPPI
BOARD OF WATER COMMISSIONERS
416 North State Street
Jackson, Mississippi 39201

CODED

WATER WELL DRILLERS LOG

7-138 1973 Singer-Lume Central Div. Hinds
date well completed firm name county well located

LANDOWNER:	description of formations encountered	from	to
<u>Hinds General Hospital</u>	<u>Clay</u>	<u>0</u>	<u>27</u>
<u>Jackson, Miss.</u>	<u>Blue Clay</u>	<u>27</u>	<u>270</u>
(mailing address)	<u>Sandy Shale</u>	<u>270</u>	<u>570</u>
WELL LOCATION:	<u>Hard Shale</u>	<u>570</u>	<u>705</u>
sec. <u>12</u> T. <u>5</u> N. R. <u>1</u> W.	<u>Shale - Sandy streaks</u>	<u>705</u>	<u>801</u>
(distance) miles (direction) of (nearest town)	<u>Hard Shale</u>	<u>801</u>	<u>833</u>
WELL PURPOSE: <u>Domestic</u>	<u>Shale, Sandy streaks</u>	<u>833</u>	<u>888</u>
(home, irrigation, municipal, industrial)	<u>Sandy Clay</u>	<u>888</u>	<u>942</u>
WELL COMPLETION DATA:	<u>Sand & Shale streaks</u>	<u>942</u>	<u>995</u>
(1) diameter (inches) <u>6"</u>	<u>Shale - Sand streaks</u>	<u>995</u>	<u>1090</u>
(2) total depth (feet) <u>993'</u>	<u>Hard Shale</u>	<u>1090</u>	<u>1213</u>
(3) static water level (feet) <u>262'</u> below above top of ground.			
(4) casing <u>Steel</u> <u>936'</u>			
(material) (depth)			
<u>6"</u> if telescope see back.			
(size) <u>+ 35' 2 4"</u>			
(5) screen <u>50'</u> <u>941'</u>			
(length) (depth to top)			
<u>4"</u> <u>Stainless Steel</u>			
(size) (material)			
(6) pump <u>15</u> <u>75</u>			
(HP) (yield gpm)			
<u>Electric</u>			
(type power)			
(7) electric log <u>yes</u>			
(yes or no)			
<u>Miss. Res. Survey</u>			
(organization running log)			
(8) how well bottom plugged <u>Valve</u>			
DRILLERS REMARKS:			


CODED

AUG 2 1973

MISS. Bd. OF WATER COMM.

If well telescopes please sketch and show depths.

GROUND LEVEL

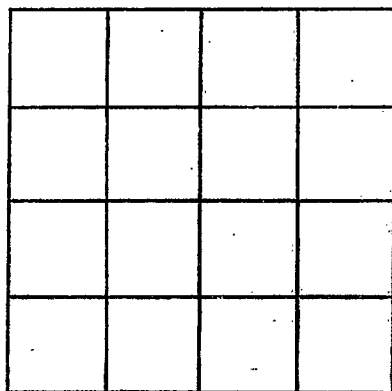

SECTION _____

Please indicate well location X.

ADDITIONAL INFORMATION

If more than one screen,
show locations of each on sketch.