

Hinds
Mill
2-5-80
Elog 671

MISSISSIPPI
BOARD OF WATER COMMISSIONERS
416 North State Street
Jackson, Mississippi 39201

CODED

WATER WELL DRILLERS LOG

2/5/80 19 Jack C. Quinn Well Co. Hinds
date well completed firm name county well located

LANDOWNER: Memphis Lake

(mailing address)

WELL LOCATION:
sec 30 T 5 N (S) (R) 1 E (W)
East miles 4 of Raymond
(distance) (direction) (nearest town)

WELL PURPOSE: Home
(home, irrigation, municipal, industrial)

- WELL COMPLETION DATA:
- (1) diameter (inches) 6 1/4 in
 - (2) total depth (feet) 1053
 - (3) static water level (feet) 200 below top of ground.
 - (4) casing steel, 920 ft (material) (depth)
4 1/2 in if telescope see back. (size)
 - (5) screen 20 ft, 920 ft (length) (depth to top)
2 1/2, Stainless Steel (size) (material)
 - (6) pump 5 HP, 35 gal.* (HP) (yield/gpm)
Electric (type power)
 - (7) electric log Yes (yes or no)
M. S. S. (organization running log)
 - (8) how well bottom plugged back
wash valve

description of fomations encountered	from	to
Top soil	0	10
Red sand	10	40
yellow clay	40	120
sand	120	170
Shell	170	250
sand	250	290
Clay	290	890
sand	890	1053

CODED

DRILLERS REMARKS:


DEPT. OF NATURAL RESOURCES
BUREAU OF LAND & WATER RESOURCES

JAN 22 1982

RECEIVED

If well telescopes please sketch and show depths.

GROUND LEVEL

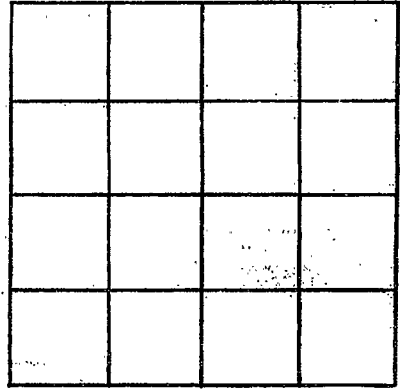

RECEIVED

82 JAN 22 A 8: 06

SECTION _____

Please indicate well location X.

ADDITIONAL INFORMATION

Lined area for additional information.

If more than one screen, show locations of each on sketch.