

MISSISSIPPI DEPARTMENT OF NATURAL RESOURCES

Bureau of Land and Water Resources

Southport Mall

P.O. Box 10631

Jackson, Mississippi 39209

WATER WELL DRILLERS LOG

CODED

HINDS
M116
8-18-83

August 18 19 83 Herndon Well & Supply Hinds
date well completed firm name county well located

LANDOWNER: Robert Fisher
Route 7 Box 107
Jackson, Ms. 39209
(mailing address)

WELL LOCATION:
sec. 17 T. 15 (N) R. 1 E (W)
1/2 Mi. miles W. of Jackson
(distance) (direction) (nearest town)

WELL PURPOSE: Home
(home, irrigation, municipal, industrial)

- WELL COMPLETION DATA:
- (1) diameter (inches) 4x2
 - (2) total depth (feet) 715
 - (3) static water level (feet) 265 ^{below} _{above} top of ground.
 - (4) casing PVC (material), 370' (depth),
4" (size) If telescope see back.
 - (5) screen 20' (length), 695' (depth to top)
2" (size), Stainless Steel (material)
 - (6) pump 1 (HP) 10GPM (yield gpm)
(type power)
 - (7) electric log Yes (yes or no)
M.S.G.S. (organization running log)
 - (8) how well bottom plugged Cap

description of formations encountered	from	to
Clay	0	10
Limestone	10	23
Blue Clay	23	60
Fine Sand	60	70
Blue Clay	70	440
Shale	440	580
Choppy Sand	580	675
Coarse Sand	675	718

DEPT. OF NATURAL RESOURCES
BUREAU OF LAND & WATER RESOURCES


AUG 19 1983

RECEIVED

DRILLERS REMARKS:

If well telescopes please sketch and show depths.

GROUND LEVEL

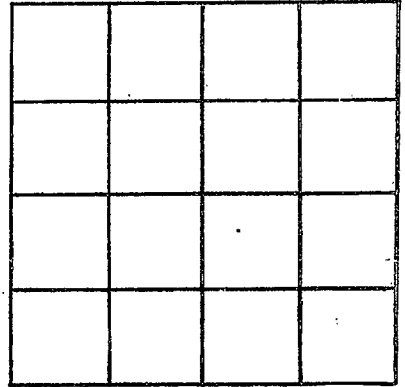

SECTION: _____

Please indicate well location X.

ADDITIONAL INFORMATION

If more than one screen,
show locations of each on sketch.