

M 2000

9-61

WATER WELL DRILLERS LOG

Date: SEPT, 1961, Driller: MCNEECE DRILLING Co. County HINDS

(Name)

(1) Owner of Land: H.C. BROWN
(Name)

RT. 2, RAYMOND MISS.
(Address)

E 1/2 SE 1/4 - SW 1/4 W 1/2 SW 1/4 SE 1/4
(2) Location: 1/4, 1/4, Sec. 19 T. 5 R. 14 W.

4 miles E, of RAYMOND,
(distance) (direction) (Nearest Town)

(3) Topography: HILLY
(Hilly) (Flat) (Level)

(4) Purpose of Well: DOMESTIC HOME
(Domestic Irrigation Municipal, Industrial, Other)

Description & Color of Materials Sand, Clay, Red Clay, Shell, etc.	Thick- ness Feet	Depth Feet
SURFACE SOIL	3	0
WHITE SHALE	27	3
BLACK SHALE	72	30
ROCK LEDGES	43	102
SHALE + SAND	70	145
LIGNITE	22	215
GREY SHALE	458	237
SAND, SHELL + SHALE	23	695
SHALE + SAND	23	718
SHALE	22	741
SHALE + SAND	81	763
SAND	43	844
SHALE	7	887
		894

Information upon completion of well:

(1) Diameter 4 X 2 inches.

(2) Total Depth 894 feet.

(3) Water Level 170 feet below top of ground.

(4) Cased to 340 FT, Size 4"
340' - 894' - 2"


(5) Screen: Size 2", Length 30

(6) Were any formations sealed against pollution?
no

If YES depth of formation _____

Why _____

Drillers Remarks: _____

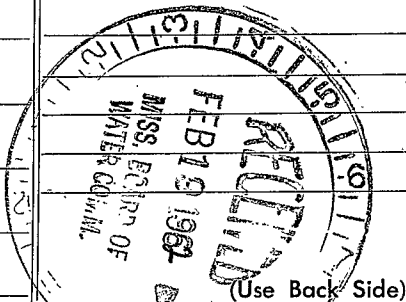

Well No. 22