

HINDS MISSISSIPPI BOARD OF WATER COMMISSIONERS

M 2001

6-28-62

WATER WELL DRILLERS LOG

Date: July 23, 1962, Driller: W. H. Butler County Smith

(Name)

(1) Owner of Land: H. H. Smith
(Name)

Clinton Miss.
(Address)

(2) Location: 1/4, 1/4, Sec. 19 15^N R 11^W

4 miles South of Clinton
(distance) (direction) (Nearest Town)

(3) Topography: (Hilly) (Flat) (Level)

(4) Purpose of Well: Domestic Home
(Domestic Irrigation, Municipal, Industrial, Other)

Description & Color of Materials
Sand, Clay, Red Clay, Shell, etc.

Thick-
ness
Feet

Depth
Feet

Chalk	1-	10
Chalk + Rock	10-	20
Rock	20-	30
Hard Chalk	30-	40
Blue Chalk	40-	60
Sand	60-	65
Chalk - gray	65-	115
Rock	115-	155
Sand + shell	155-	165
Light Sand	165-	170
Sand + Chalk	170-	180
Sands	180-	208
Blue shell	208-	228
Sand + Shell	228-	258
Gumbo	258-	268
Sand + Chalk	268-	288
Gumbo	288-	348
Shale	348-	431

Information upon completion of well:

(1) Diameter 2" inches.

(2) Total Depth 208 feet.

(3) Water level 70 feet below top of ground.

(4) Cased to 188, Size 2"

(5) Screen: Size 2", Length 20'


(6) Were any formations sealed against pollution?

no

If YES depth of formation _____

Why _____

Drillers Remarks: _____

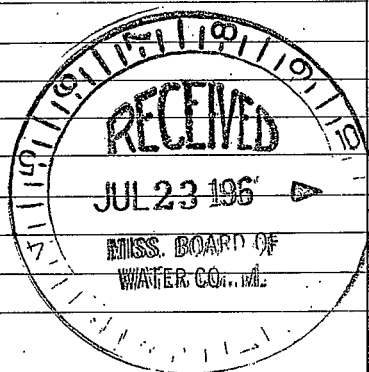

(Use Back Side)

Well No.