

HINDS

MISSISSIPPI BOARD OF WATER COMMISSIONERS

M 2009


9-21-62

WATER WELL DRILLERS LOG

Date: SEPT, 21, 1962, Driller: McNEECE DRILLING Co. County HINDS

(Name)

(1) Owner of Land: BOB CORKERN (Name)	Description & Color of Materials Sand, Clay, Red Clay, Shell, etc.	Thick- ness Feet	Depth Feet
R.I. JACKSON MISS (Address)	SURFACE SOIL	3	3
(2) Location: S 1/2, N 1/2, Sec. 19 T 5N R1W	WHITE SHALE	19	22
4 miles S of CLINTON (distance) (direction) (Nearest Town)	GREY SHALE	18	40
(3) Topography: HILLY (Hilly) (Flat) (Level)	WHITE SAND	4	44
(4) Purpose of Well: DOMESTIC Home (Domestic Irrigation Municipal, Industrial, Other)	GREY SHALE	49	93
Information upon completion of well:	ROCK LEDGES	41	134
(1) Diameter 4" X 2" inches.	SHALE & SAND	71	205
(2) Total Depth 880 feet.	FINE SAND	9	214
(3) Water Level 180 feet below top of ground.	SHALE & SAND	16	230
(4) Cased to 330 <sup>860</sup> , Size 4" 330 to 880 - 2"	COARSE SAND	13	243
(5) Screen: Size 2", Length 20	GREY SHALE	330	573
(6) Were any formations sealed against pollution? yes, X no.	SHALE & ROCK	119	692
If YES depth of formation _____	SHELL, SHALE & SAND	26	718
Why _____	FINE SAND & SHALE	103	821
Drillers Remarks: _____	COARSE SAND	53	874
_____	SHALE	6	880
_____			
_____			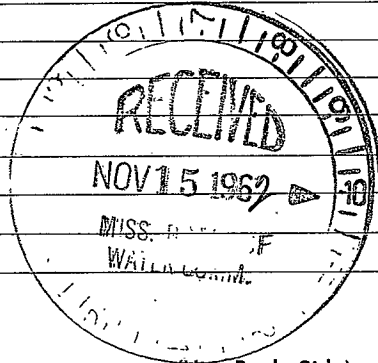
(Use Back Side)

Well No. 42