

HINDS

MISSISSIPPI BOARD OF WATER COMMISSIONERS

M 7003

10-62

WATER WELL DRILLERS LOG

Date: OCT, 1962, Driller: McNEECE DRILLING Co. County HINDS

(Name)

(1) Owner of Land: <u>VARNER, EADY, CRAWFORD</u> (Name)	Description & Color of Materials Sand, Clay, Red Clay, Shell, etc.	Thick- ness Feet	Depth Feet
<u>R.I. JACKSON MISS.</u> (Address)	SURFACE SOIL	3	3
(2) Location: <u>NW 1/4, NW 1/4, Sec. 32 T 5N R1W</u> <u>6</u> miles <u>E</u> of <u>RAYMOND</u> (distance) (direction) (Nearest Town)	WHITE SHALE	9	14
(3) Topography: <u>FLAT</u> (Hilly) (Flat) (Level)	RED SHALE	10	24
(4) Purpose of Well: <u>DOMESTIC Home</u> (Domestic Irrigation Municipal, Industrial, Other)	GREY SHALE	60	84
	ROCK LEDGES	46	130
	SHALE & SAND	55	185
	SHALE	52	237
	COARSE SAND	51	288
	SHALE (GREY)	410	698
	SHELL, SHALE & SAND	25	723
	SHALE & SAND	95	818
	COARSE SAND	31	849
	SHALE & SAND	21	870


Information upon completion of well:

- (1) Diameter 4"x2" inches.
- (2) Total Depth 870 feet.
- (3) Water Level 180 feet below top of ground.
- (4) Cased to 340 880, Size 4"
340 to 870 - 2"
- (5) Screens: Size 2", Length 20'
- (6) Were any formations sealed against pollution?
_____ yes, X no.

If YES depth of formation _____

Why _____

Drillers Remarks: _____

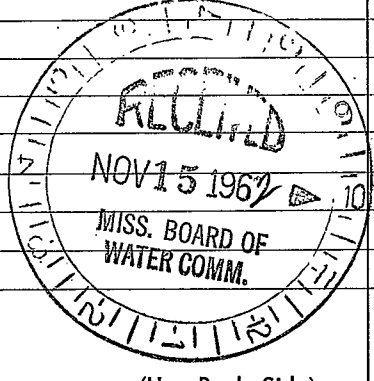

(Use Back Side)

Well No. 43