

M 2004
10-1-64

WATER WELL DRILLERS LOG

Date: OCT 1, 1964, Driller: ELLS & HALL County HINDS
HALL DRILLING CO


| (1) Owner of Land: | | Description & Color of Materials Sand, Clay, Red Clay, Shell, etc. | Thick- ness Feet | Depth Feet |
|--|--|---|------------------------|---------------|
| <u>HINDS COUNTY WATERED</u> (Name) | | <u>SURFACE SOIL</u> | <u>4</u> | <u>4</u> |
| <u>PO BOX 8127 JACKSON MISS</u> (Address) | | <u>GRAY MARL SAND +</u> | | |
| <u>COLLEGE HEIGHT SUB SN 1W</u> (2) Location: <u>1/4</u> , <u>1/4</u> , Sec. <u>1</u> <u>R 1W</u> | | <u>ROCK</u> | <u>40</u> | <u>44</u> |
| <u>2</u> miles <u>S</u> of <u>CLINTON</u> (distance) (direction) (Nearest Town) | | <u>YAZOO CLAY</u> | <u>44</u> | <u>49</u> |
| (3) Topography: <u>HILLY</u> (Hilly) (Flat) (Level) | | <u>MOODY'S BRANCH</u> | <u>25</u> | <u>516</u> |
| (4) Purpose of Well: <u>MUNICIPAL</u> (Domestic Irrigation Municipal, Industrial, Other) | | <u>SAND SHALE + LIGNITE</u> | <u>39</u> | <u>555</u> |
| | | <u>FINE GRAN SAND + SHALE</u> | <u>34</u> | <u>589</u> |
| | | <u>SAND SHALE + LIGNITE</u> | <u>39</u> | <u>628</u> |
| | | <u>COURSE SAND</u> | <u>46</u> | <u>674</u> |

Information upon completion of well:

- (1) Diameter 4 X 2 1/2 inches.
- (2) Total Depth 674 feet.
- (3) Water Level 217 feet below top of ground.
- (4) Cased to 394 6 3/4 Size 4"
240 2 1/2"
- (5) Screen: Size 2 1/2, Length 40'
- (6) Were there any formations sealed against pollution?
_____ yes, X no.

If YES depth of formation _____
Why _____

Drillers Remarks: _____

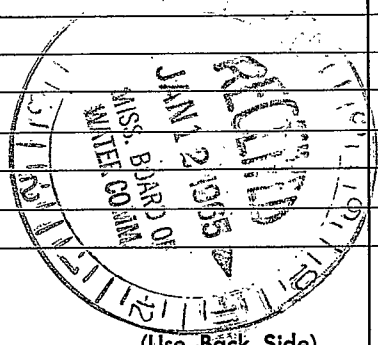

(Use Back Side)

Well No. 2