

HINDS

M 205

MISSISSIPPI BOARD OF WATER COMMISSIONERS

2-22-65 WATER WELL DRILLERS LOG

Hinds

Date: 2/22, 1965, Driller: Forest Drilling Co. (Name)

(1) Owner of Land: J.M. Price (Name)

117 Armita St Jackson, Miss (Address)

(2) Location: 1/4, 1/4, Sec. T5N1W

10 miles South of Clifton, Springfield Rd. (distance, direction, Nearest Town)

(3) Topography: (Hilly) (Flat) (Level)

(4) Purpose of Well: Home (Domestic Irrigation, Municipal, Industrial, Other)

Description & Color of Materials Sand, Clay, Red Clay, Shell, etc.	Thick- ness Feet	Depth Feet
Clay + limy Rock		26
Shale + Shale Rock		104
Fine sand		133
Shale		135
Fine sand		143
Med. sand + Rock		164
Clay + Shale		245
Clay + Shale Rock		270
Rock + Shale		307
Shale + Shale Rock		327
Shale + lignite		368
Soft shale		451
Hard shale		534
Soft shale + Shale		893
Fine sand		934
		986

Information upon completion of well:

(1) Diameter 2 inches.

(2) Total Depth 986 feet.

(3) Water Level 280 feet below top of ground.

(4) Cased to 966, Size 2"


(5) Screen: Size 2", Length 20ft.

(6) Were any formations sealed against pollution? yes, no.

If YES depth of formation

Why

Drillers Remarks:

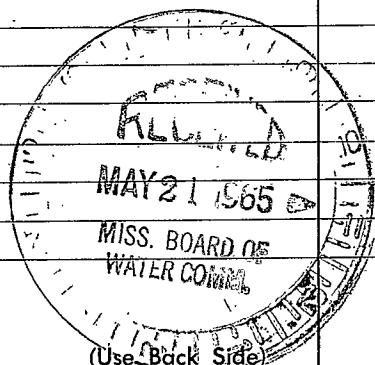

Well No.