

m 2009  
11-65

WATER WELL DRILLERS LOG

Date: 11-7, 1965, Driller: HALL DRILLING CO County HINDS  
(Name)

HINDS COUNTY WATER CO  
(1) Owner of Land:

(Name)

P.O. BOX 8127 JACKSON MISS  
(Address)

(2) Location: S.W. 1/4, 1/4, Sec. 6 T5N R1W

3 1/2 miles S.W., of CLINTON,  
(distance) (direction) (Nearest Town)

(3) Topography: HILLY

(Hilly) (Flat) (Level)

(4) Purpose of Well: MUNICIPAL

(Domestic Irrigation  
Municipal, Industrial, Other)

Description & Color of Materials Sand, Clay, Red Clay, Shell, etc.	Thick- ness Feet	Depth Feet
<u>SURFACE SOIL</u>	<u>4</u>	<u>4</u>
<u>LIGHT GRAY + PINK MARL</u>	<u>20</u>	<u>24</u>
<u>WHITE SAND + MARL</u>	<u>40</u>	<u>64</u>
<u>GRAY SAND + SHALE</u>	<u>149</u>	<u>213</u>
<u>YAZOO CLAY</u>	<u>352</u>	<u>565</u>
<u>MOODY BRANCH</u>	<u>20</u>	<u>585</u>
<u>SAND + SHALE</u>	<u>177</u>	<u>762</u>
<u>MED GRAIN SAND</u>	<u>52</u>	<u>814</u>
<u>SAND + SHALE</u>	<u>24</u>	<u>838</u>
<u>SHALE</u>	<u>1</u>	<u>839</u>

Information upon completion of well:

(1) Diameter 4 X 2 1/2 inches.

(2) Total Depth 839 feet.

(3) Water Level 203 feet below top of ground.

(4) Cased to 400' 799, Size 4"  
399' 2 1/2

(5) Screen: Size 2 1/2, Length 40'


(6) Were there any formations sealed against pollution?

yes,  no.

If YES depth of formation \_\_\_\_\_

Why \_\_\_\_\_

Drillers Remarks: \_\_\_\_\_

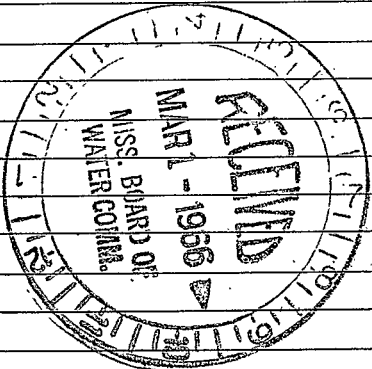

22

Well No.

(Use Back Side)