

MISSISSIPPI
BOARD OF WATER COMMISSIONERS
416 North State Street
Jackson, Mississippi 39201

WATER WELL DRILLERS LOG

April 19 67 Hall Drilling Co Hinds
date well completed firm name county well located

LANDOWNER:

Charles Dillingham

description of formations encountered

from to

Jackson, Miss.
(mailing address)

WELL LOCATION:

sec. 32 T 5 N R 1 W
8 miles SW of Jackson
(distance) (direction) (nearest town)

WELL PURPOSE: Home
(home, irrigation, municipal, industrial)

WELL COMPLETION DATA:

- (1) diameter (inches) 4" x 2"
- (2) total depth (feet) 856
- (3) static water level (feet) 204 below top of ground.
- (4) casing STEEL, 836
(material) (depth)
4" x 2" if telescope see back.
(size)
- (5) screen 20' (length) (depth to top)
2" STAINLESS STEEL
(size) (material)
- (6) pump 10 (HP) 10 (yield gpm)
ELECTRIC
(type power)
- (7) electric log NO (yes or no)
(organization running log)
- (8) how well bottom plugged backwash valve

Surface Soil	0	10
White Marl	10	20
White Sand	20	27
SHALE	27	115
Rock	115	155
Sand & Sea Shell	155	160
Sand & Shale	160	273
Medium Sand	273	299
Yazoo Clay	299	717
Moody Branch	717	733
Sand & Lignite & Shale	733	823
Coarse Sand & Shale	823	856
STREAKS		



DRILLERS REMARKS:


If well telescopes please sketch and show depths.

GROUND LEVEL

355' 4"
CASING

481' 2"
CASING

20' 2"
SCREEN

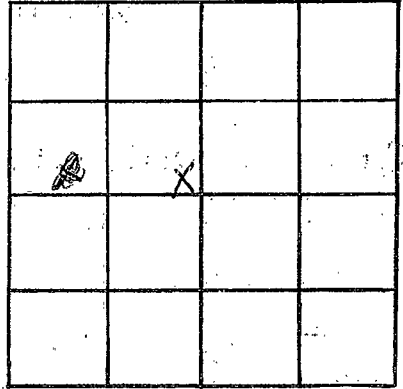

SECTION 32

Please indicate well location X.

ADDITIONAL INFORMATION

If more than one screen,
show locations of each on sketch.