

MISSISSIPPI DEPARTMENT OF NATURAL RESOURCES

Bureau of Land and Water Resources

Southport Mall

P.O. Box 10631

Jackson, Mississippi 39209

WATER WELL DRILLERS LOG

Hinds
M 9012

March 17
date well completed

E. M. Lee
firm name

Hinds
county well located

LANDOWNER:
Sam H. Tucker
Rt. 1, Terry, MS.
(mailing address)

description of formations encountered	from	to
<u>Surface</u>	<u>0</u>	<u>25</u>
<u>Grey shale hard</u>	<u>25</u>	<u>130</u>
<u>Sand - good</u>	<u>130</u>	<u>190</u>

WELL LOCATION:
sec. 31 T. 5 N. R. 1 W.
6 miles SW Jackson
(distance) (direction) (nearest town)

WELL PURPOSE: Home
(home, irrigation, municipal, industrial)

- WELL COMPLETION DATA:
- (1) diameter (inches) 4
 - (2) total depth (feet) 190
 - (3) static water level (feet) 140 below top of ground.
 - (4) casing PVC 170
(material) (depth)
4 if telescope see back.
(size)
 - (5) screen 20 170
(length) (depth to top)
4 PVC
(size) (material)
 - (6) pump 1 15
(HP) (yield gpm)
(type power) no
 - (7) electric log (yes or no)
(organization running log)
 - (8) how well bottom plugged
Sand shank

RECEIVED


APR 14 1967

Department of Natural Resources
Bureau of Land & Water Resources

DRILLERS REMARKS:

If well telescopes please sketch and show depths.

GROUND LEVEL

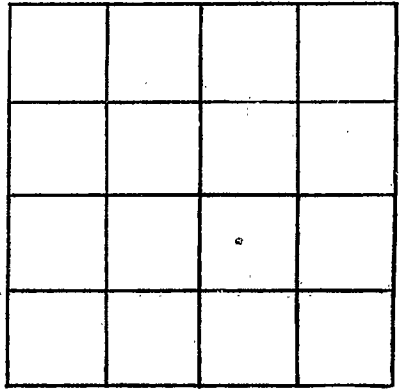

SECTION _____

Please indicate well location X.

ADDITIONAL INFORMATION

A series of horizontal lines for recording additional information, starting below the 'ADDITIONAL INFORMATION' header and extending to the bottom of the page.

If more than one screen, show locations of each on sketch.