

HINDS

MISSISSIPPI BOARD OF WATER COMMISSIONERS

N 77 (69)

2/4/74 R.G.

CODED

4-64

WATER WELL DRILLERS LOG

Date: APRIL, 19 64, Driller: R.G. MCNEECE DRILLING Co. County HINDS

(Name Co.)

(1) Owner of Land: JACKSON PACKING Co.
 (Name)
 2520 S. GALLATIN ST, JACKSON MISS
 (Address)

(2) Location: 1/4, SW 1/4, Sec. 15 T. 15 N. R. 15 E.
 miles IN, of JACKSON, MISS.
 (distance) (direction) (Nearest Town)

(3) Topography: Hilly
 (Hilly) (Flat) (Level)

(4) Purpose of Well: INDUSTRIAL
 (Domestic Irrigation
 Municipal, Industrial, Other)

Description & Color of Materials Sand, Clay, Red Clay, Shell, etc.	Thick- ness Feet	Depth Feet
YELLOW SHALE	8	8
GREY SHALE	96	104
SHALE + SAND	88	192
SHALE + LIGNITE	20	212
ROCK	1	213
SHALE + SAND	43	256
ROCK + SAND	31	287
COARSE SAND	64	351
SHALE + SAND	11	362
SHALE	38	400
ROCK	3	403
SHALE	16	419
SHALE + ROCK	42	461
SHALE	6	467
ROCK	3	470
SAND + SHALE	34	504
SAND + SHALE	44	548
SAND	28	576
SHALE	14	590
SHALE + LIGNITE	35	611
SHALE, SAND + LIGNITE	21	632
SAND	138	770
SHALE	5	775

Information upon completion of well:

(1) Diameter 8x6 inches.

(2) Total Depth 775 feet.

(3) Water Level 160 feet below top of ground.

(4) Cased to 407' 4", Size 8"

(5) Screen: Size 6", Length 60'


(6) Were any formations sealed against pollution?
 yes, no.

If YES depth of formation

Why

Drillers Remarks:

CODED

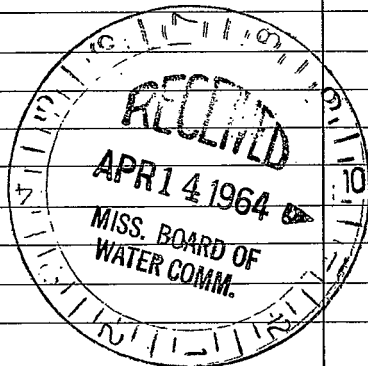

(Use Back Side)

Well No. 68