

Hinds
N-70
4-67

MISSISSIPPI
 BOARD OF WATER COMMISSIONERS
 416 North State Street
 Jackson, Mississippi 39201 Log # 267

WATER WELL DRILLERS LOG

4/7 1967 Hall Drilling Co. Hinds
 date well completed firm name county well located

LANDOWNER:

INTERSTATE Park, Inc.

Jackson, Miss.
 (mailing address)

WELL LOCATION:

sec. 32 T. 5 N. R. 1 E. #
3 miles S of Jackson
 (distance) (direction) (nearest town)

WELL PURPOSE: Commercial
 (home, irrigation, municipal, industrial)


WELL COMPLETION DATA:

- (1) diameter (inches) 4 x 2 1/2
- (2) total depth (feet) 1033
- (3) static water level (feet) 196 below above top of ground.
- (4) casing Steel (material) (depth)
4 x 2 1/2 if telescope see back. (size)
- (5) screen 40' 993' (length) (depth to top)
2 1/2 STAINLESS STEEL (size) (material)
- (6) pump 5 36 (HP) (yield gpm)
ELECTRIC (type power)
- (7) electric log yes (yes or no)
STATE GEO. (organization running log)
- (8) how well bottom plugged
backwash valve

description of formations encountered

from to

Surface Soil	0	4
Grey marl	4	12
White Sand	12	30
Shale	30	40
Yazoo Clay	40	286
Moody Branch	286	308
Five sand & shale	308	453
Sand & Shale	453	520
Sand	520	564
Shale	564	648
Shale & Pure Lime	648	669
Shale & Rock	669	775
Sand & Lignite	775	841
Shale	841	863
Sand & Shale	863	884
Coarse Sand	884	936
Shale	936	968
Sand & Shale	968	990
Sand	990	1033

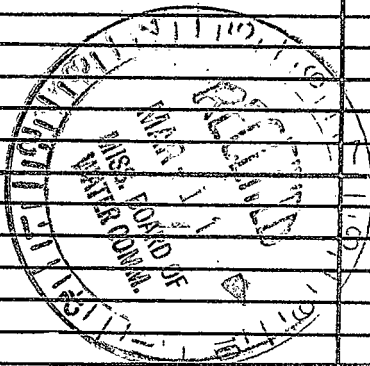

DRILLERS REMARKS:

If well telescopes please sketch and show depths.

GROUND LEVEL

400' - 4"

993' - 2 1/2"

1033' - 2 1/2"

SCREEN

		X	

SECTION 32

Please indicate well location X.

ADDITIONAL INFORMATION

If more than one screen, show locations of each on sketch.