

**MISSISSIPPI
BOARD OF WATER COMMISSIONERS**
416 North State Street
Jackson, Mississippi 39201

CODED

WATER WELL DRILLERS LOG

Hinds
N 71
1-25-70

1/35 1970 Forest Drilling Hinds
date well completed firm name county well located

LANDOWNER: W. R. Jett
Rt. 5, Box 15
Jackson, Mississippi
(mailing address)

description of formations encountered	from	to
Brown clay	0	26
Blue clay	26	210
Shale	210	286
Clay + sandy shale	286	307
Shale + silt	307	347
Soft shale	347	368
Shale	368	410
Shale + other sand	410	420
Fine sand + other clay	420	431
Fine sand	431	435
Dirt sand + shale	435	517
Fine sand + other clay	517	534
Shale	534	551
Shale + other sand	551	573
Shale	573	635
Shale + rock	635	655
Shale	655	675
Shale + other rock	675	716
Shale	716	776
Shale + other sand	776	856
Shale	856	886
Packed fine sand, other clay	886	912
Packed sand	912	920
Clay + fine sand	920	941
Fine sand + other shale	941	983
Fine sand	983	1052
Fine sand + clay	1052	1067

WELL LOCATION:
sec. 2 T. 5 N R. 1 E
1 miles So of Jackson
(distance) (direction) (nearest town)

WELL PURPOSE: Home
(home, irrigation, municipal, industrial)

WELL COMPLETION DATA:

- (1) diameter (inches) 2"
- (2) total depth (feet) 1054'
- (3) static water level (feet) 152' below top of ground.
- (4) casing Steel, 1034'
(material) (depth)
2" if telescope see back.
(size)
- (5) screen 20', 1034'
(length) (depth to top)
2", Stainless Steel
(size) (material)
- (6) pump 5, 15 (AIR)
(HP) (yield gpm)
Elect.
(type power)
- (7) electric log no
(yes or no)

(organization running log)
- (8) how well bottom plugged 2"
Backwash Valve


DRILLERS REMARKS:

FEB 27 1970

MISS. BD. OF
WATER COMM.

If well telescopes please sketch and show depths.

GROUND LEVEL

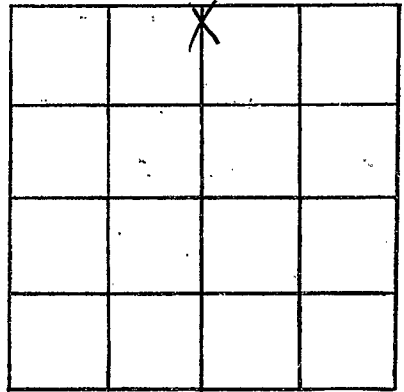

SECTION 2

Please indicate well location X.

ADDITIONAL INFORMATION

If more than one screen, show locations of each on sketch.