

HINDS  
N 73  
12-61

MISSISSIPPI BOARD OF WATER COMMISSIONERS

CODED

WATER WELL DRILLERS LOG

Date: DEC, 1961, Driller: RIVENEECE DRILLING CO., County HINDS

(Name)

(1) Owner of Land: CARMELITE MONASTARY  
(Name)

2155 TERRY RD. JACKSON MISS

SE 1/4, NE 1/4 & SW 1/4, NE 1/4, N 17 5/8 E

(2) Location: 1/4, 1/4, Sec. 17 T 5 R 1 E  
1 N JACKSON  
(distance) miles (direction) of (Nearest Town)

(3) Topography: Hilly  
(Hilly) (Flat) (Level)

(4) Purpose of Well: DOMESTIC  
(Domestic Irrigation  
Municipal, Industrial, Other)

Description & Color of Materials  
Sand, Clay, Red Clay, Shell, etc.

Thick-  
ness  
Feet

Depth  
Feet

SURFACE SOIL	3	0
YELLOW MARL	35	38
GREY SHALE	156	194
SHALE + FINE SAND	175	369
GREY SHALE	81	450
SANDY SHALE	45	495
ROCK LEDGES	22	517
SHALE + SAND + LIG.	122	639
SAND	146	785

Information upon completion of well:

(1) Diameter 2 inches.

(2) Total Depth 785 feet.

(3) Water Level 200 feet below top of ground.

(4) Cased to 785, Size 2"

(5) Screen: Size 2", Length 20'

(6) Were any formations sealed against pollution?


yes,  no.

If YES depth of formation

Why

Drillers Remarks:

CODED

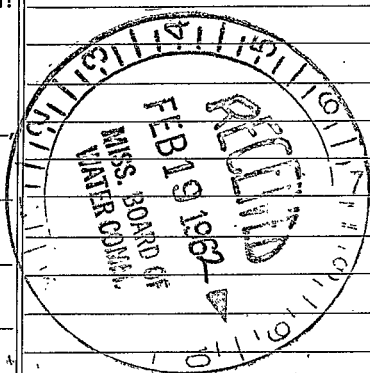

(Use Back Side)

