

N75
1-24-61

WATER WELL DRILLERS LOG

CODED

Date: 1. 24, 1961, Driller: McDonald Hill County: HINDS
(Name)

(1) Owner of Land: Sandifer Gas Co
(Name)
Jackson Miss
(Address)

(2) Location: 1/4, 1/4, Sec. 15 SW 1/4 E
T. R.

2 miles S East, of Jackson
(distance) (direction) (Nearest Town)

(3) Topography: X
(Hilly) (Flat) (Level)

(4) Purpose of Well: Domestic
(Domestic Irrigation
Municipal, Industrial, Other)

Description & Color of Materials Sand, Clay, Red Clay, Shell, etc.	Thick- ness Feet	Depth Feet
<u>Gravel</u>	<u>0</u>	<u>8</u>
<u>Sand</u>	<u>8</u>	<u>10</u>
<u>Clay</u>	<u>10</u>	<u>12</u>
<u>Sand</u>	<u>12</u>	<u>24</u>
<u>Gravel</u>	<u>28</u>	<u>30</u>
<u>Gravel</u>	<u>30</u>	<u>45</u>
<u>Sandy Lime</u>	<u>49</u>	<u>126</u>
<u>Soft Mud</u>	<u>126</u>	<u>250</u>
<u>Soft Lime Rock</u>	<u>250</u>	<u>290</u>
<u>Med Mud</u>	<u>290</u>	<u>350</u>
<u>Rock</u>	<u>350</u>	<u>354</u>
<u>Soft Mud</u>	<u>354</u>	<u>485</u>
<u>Sandy Lime Shale</u>	<u>485</u>	<u>605</u>
<u>Soft Sand</u>	<u>605</u>	<u>675</u>
<u>Sand</u>	<u>675</u>	<u>720</u>

Information upon completion of well:

(1) Diameter 4x2 inches.

(2) Total Depth 710 feet.

(3) Water Level 115 feet below top of ground.

(4) Cased to 315' total = 4" total, Size 3" 6.95

(5) Screen: Size 2, Length 6'


(6) Were any formations sealed against pollution?
_____ yes, X no.

If YES depth of formation _____

Why _____

Drillers Remarks: _____

CODED

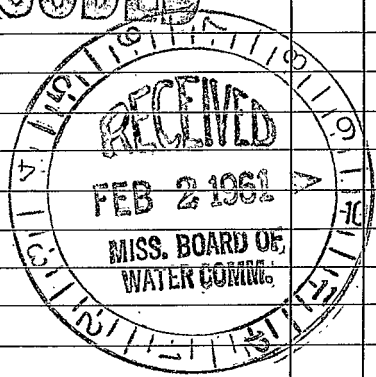

(Use Back Side)

Well No.

