

**HINDS**  
**NPO**  
**7-30-73**  
**E log 522**

MISSISSIPPI  
 BOARD OF WATER COMMISSIONERS  
 416 North State Street  
 Jackson, Mississippi 39201

**CODED**

**WATER WELL DRILLERS LOG**

7/30 1973 Forest Drilling Hinds  
 date well completed firm name county well located

LANDOWNER: Ms James & Jh  
Jackson Museum  
Jackson, Miss  
 (mailing address)  
 WELL LOCATION:  
 sec. 3 T. 5 N R. 1 E  
111 N. Jefferson St. of Jackson  
 (distance) miles (direction) (nearest town)

description of formations encountered	from	to
Clay	0	12
Clay + fine sand	12	270
Clay + Rock	270	274
clay	274	316
Hard shale	316	378
Hard shale + Rock	378	398
Fine sand + St. Clay	398	490
Clay + St. sand	490	562
Yah sand	562	706
Fine sand	706	726
Clay + fine sand	726	747

WELL PURPOSE: Commercial  
 (home, irrigation, municipal, industrial)

- WELL COMPLETION DATA:
- diameter (inches) 4"
  - total depth (feet) 747
  - static water level (feet) 184 below top of ground.
  - casing 4" Steel 747  
 (material) (depth)  
 (size) If telescope see back.
  - screen 25x2 1/2" 722  
 (length) (depth to top)  
2 1/2" 5" Steel  
 (size) (material)
  - pump 5 Sub. 30  
 (HP) (yield gpm)  
207V-3PH-  
 (type power)
  - electric log Yes  
 (yes or no)  
U.S. Geo.  
 (organization running log)
  - how well bottom plugged 2" BW Valve


**CODED**

DRILLERS REMARKS:

NOV 14 1973

If well telescopes please sketch and show depths.

GROUND LEVEL

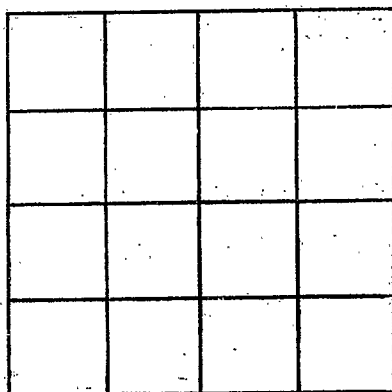

SECTION 2

Please indicate well location X.

ADDITIONAL INFORMATION

If more than one screen, show locations of each on sketch.