

MISSISSIPPI  
BOARD OF WATER COMMISSIONERS  
416 North State Street  
Jackson, Mississippi 39201

CODED

WATER WELL DRILLERS LOG

HINDS  
N 81  
24-76

Log # 578 2/4 19 76 Jack Guinn Hinds  
date well completed firm name county well located

LANDOWNER: Stegall Constr. Co.  
  
(mailing address)

description of formations encountered	from	to
YAZOO CLAY	0	320
SANDY SHALE	320	340
	340	380
CLAY	380	520
SAND	520	602

WELL LOCATION:  
sec 21 T 5 S R 1 E  
miles SE of McDowell Bn, Jackson  
(distance) (direction) (nearest town)

WELL PURPOSE: Industrial  
(home, irrigation, municipal, industrial)

- WELL COMPLETION DATA:
- (1) diameter (inches) 4 by 2
  - (2) total depth (feet) 602
  - (3) static water level (feet) 145 below top of ground.
  - (4) casing Black (375 550) (material) (depth)
  - 4 (size) if telescope see back.
  - (5) screen 20' (length) (depth to top)
  - 2" (Johnson #8) (size) (material)
  - (6) pump 5 (HP) (yield gpm)
  - 220 (type power)
  - (7) electric log yes (yes or no)
  - USGS (organization running log)
  - (8) how well bottom plugged

CODED


DRILLERS REMARKS:

RECORDED  
INDEXED  
FEB 17 1976

MISS. BD. OF WATER COMMISSIONERS

If well telescopes please sketch and show depths.

GROUND LEVEL

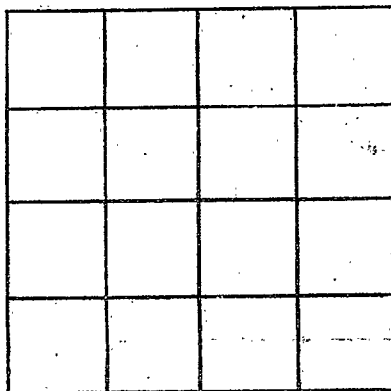

SECTION \_\_\_\_\_

Please indicate well location X.

ADDITIONAL INFORMATION

If more than one screen, show locations of each on sketch.